

KANSAS


FORM 51 5M 10-41 PETROL

Pratt

Section 6 Township 27 Range 12-W

Well No. #1 Beck

Company Hollow Drilling
Iuka Pool

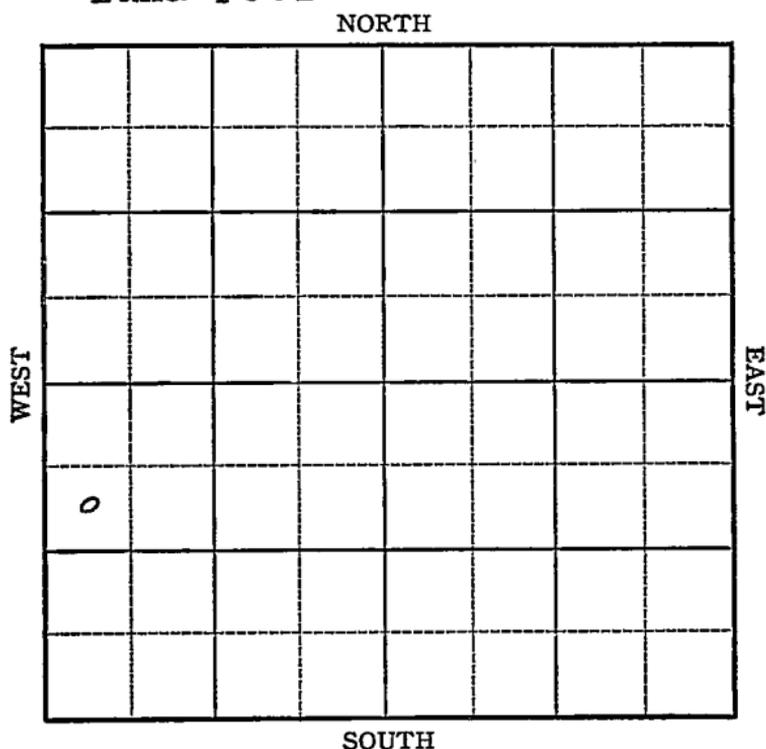

Sec. 6 Twp. 27 R. 12-W

Well No. #1 Beck Farm

Hollow Drilling Company

(Ika Pool)


990 Ft. from N. Line

_____ Ft. from S. Line

_____ Ft. from E. Line

330 Ft. from W. Line

Elev. 1870

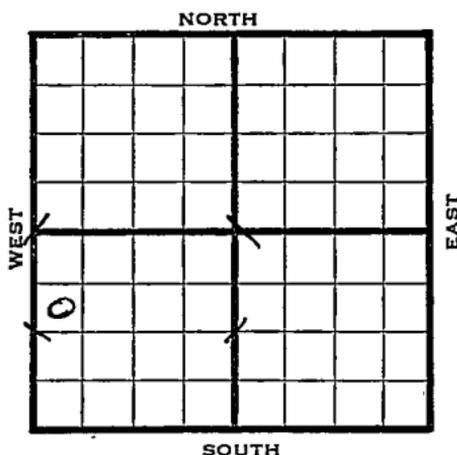

1942

REPORT

8/5	Location			
8/12	"			
8/19	"			
8/27	"			
9/2	"			
9/9	8" @ 390 WOC			
9/16	Drlg 3090			
9/23	Lansing 3692	Drilling	3975	
9/30	TD 4208 WOC.	5" - 4205		
	Viola 4115	Simp. sh	4197	
	Simp. sd 4205,	cored	4206-08	
	Rec. 6" of sat. sand.			
10/7	"	"	"	
10/14	TD 4280	$\frac{1}{4}$ M gas	SD	
10/21	"	"	"	"
10/28	"	"	"	"
11/4	"	"	"	"
11/11	"	"	"	"
11/18	"	"	"	"
11/24	"	"	"	"

OVER

1942

ID 4280 1/4 M Gas "D"

12/9 " " "

12/16 " "

12/22 " "

12/29 " " "

1943

1/6 " " "

1/13 " " "

1/20 " " "

1/27 " " "

2/3 " " "

2/10 " " "

2/17 " " "

2/24 " " "

3/3 · Simp. sd. 4205

5" @ 4205'

T.D. 4280'

No shows.

ABANDONED

Map No. 54 Sec. 6 Twp. 27 R. 12W

Well No. 1 Beck

Hollow Drilling Company

FIRST REPORT Contractor

SW NW SW


SECTION PLAT

990 Ft. from N. Line

_____ Ft. from S. Line

_____ Ft. from E. Line

330 Ft. from W. Line

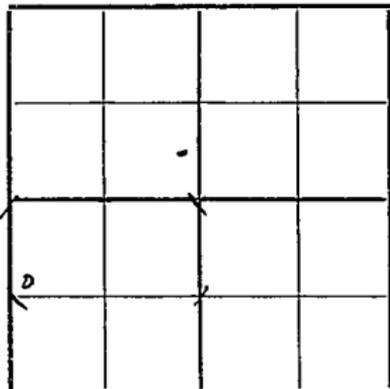

IUKA POOL

Location XXX

Rig up _____

Drilling and Remarks:

[Handwritten scribble]

RECORD

Cased _____ in., _____ ft.

Sand _____

Gas _____

Oil _____

Total Depth _____

PRODUCTION

1st 24 hrs. Nat. _____

1st 24 hrs. after shot _____

Gas _____ Cu. Ft.

Dry Hole _____

Abandoned _____

Date

AUG 5 1942

19

S. J. LEWIS

Scout

Misc. Small Maps	<i>RAY</i>
Cards	<i>Ans</i>
Tracing	<i>W</i>
France Map	<i>RAY</i>
Scarborough Map	<i>RAY</i>
Moody Map	
Geological Dept.	
Moody Plat Book	

KANSAS

Map No. 5345 Sec. 6 Twp. 27 R. 12W

Well No. 1 Beck

Hollow Drilling Company

ABANDONED Contractor

SW NW SW


SECTION PLAT

990 Ft. from N. Line

_____ Ft. from S. Line

_____ Ft. from E. Line

330 Ft. from W. Line

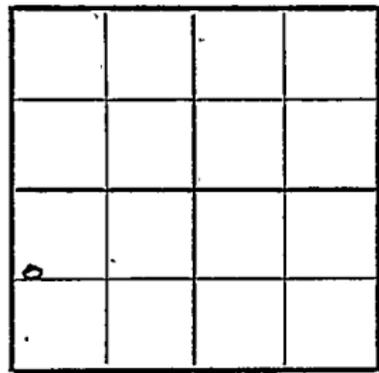

IUKA POOL

Location _____

Rig up _____

Drilling and Remarks:

Simp Col 4205-
5 to 4205-
Noeliner

RECORD

Cased _____ in., _____ ft.

Sand _____

Gas _____

Oil _____

Total Depth 4280

PRODUCTION

1st 24 hrs. Nat. _____

1st 24 hrs. after shot _____

Gas _____ Cu. Ft.

Dry Hole _____

Abandoned _____

Date

MAR 3 1943 19

S. J. LEWIS Scout

Misc Small Maps *One*

Cards *Best*

Tracing *MS*

France Map *✓*

Scarborough Map *✓*

Muddy Map *✓*

Geological Dept. *✓*

Muddy Flat Book