
FORM 51 25M 3-49 PETROL Pratt KANSAS

Section 6 Township 27 Range 12W

Well No. #3 Beck "A"

Company C R A

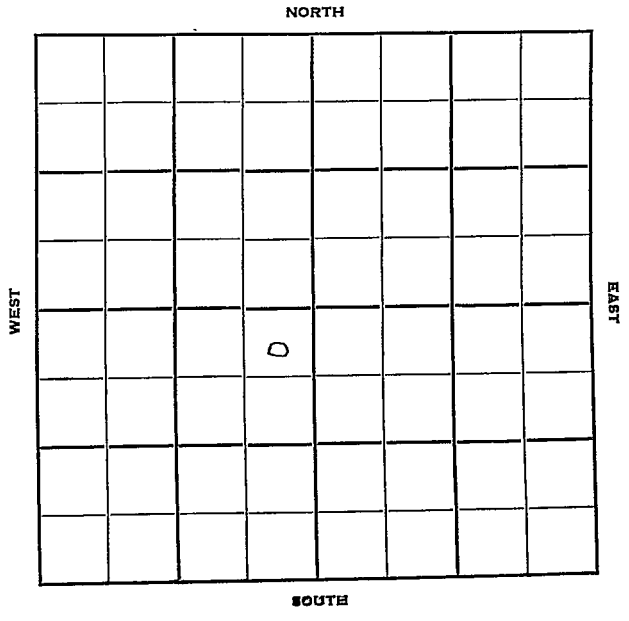

FORM 252-B
10M 11-50 PETROL

Pratt

Sec. 6 Twp. 27 R. 12W KANSAS

Well No. #3 Beck "A" Farm

C R A Company

Contractor

Iuka Pool


330' Ft. from N. Line

Ft. from S. Line

330' Ft. from E. Line

Ft. from W. Line

NE NE SW

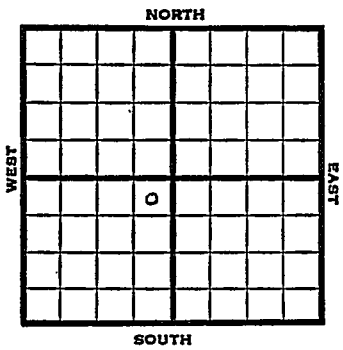

1951	Elev. 1874' REPORT
8/15	Spud 8-9-51 8" @ 397 Drlg. 2355'
10/3	Spud 8-9-51 Oil well TD 4247' 8" @ 397' Heeb 3433' Br. lime 3657' KC 3669' Miss 4062' Viola 4106' Simp. sh. 4183' Simp. sd. 4220-47' 5½" @ 4238' CO to 4247' water. PB 4243' 12/4236-39 60/4226-36 S/10½ BO 7 hr. Hydrofrac. TD 4247' F/41 BO 1 hr. F/78 BO 6 hr. Comp. BHB 3000 BOPD COMPLETED

FORM 275 FOR SALE BY KANSAS BLUE PRINT CO.


County Pratt State Kansas

Sec. 6 (Blk. Twp.) 27 (Sur. Rge.) 12W Map No.

Operator C R A

Well No. 3 Farm Beck "A"

Elev. Location NE NE SW

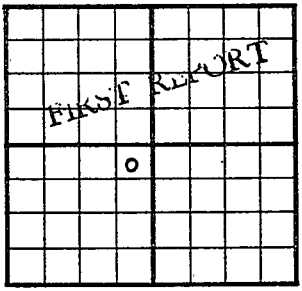

330 Ft. From N Line SW

330 Ft. From E Line Quarter

1st. Report AUG 15 1951

Completion

Remarks

Spudding Date 8-9-51

Drlg. Data Iuka Pool

8" @ 397 drlg. 2355

J. E. TYRA

FORM 275 FOR SALE BY KANSAS BLUE PRINT CO.


County Pratt State Kansas

Sec. 6 (Blk. Twp.) 27 (Sur. Rge.) 12W Map No.

Operator C RA

Well No. 3 Farm Beck "A"

Elev. 1874 Location NE NE SW

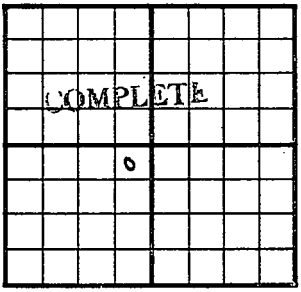

330 Ft. From N Line SW

330 Ft. From E Line Quarter

1st. Report

Completion OCT 3 1951

Remarks Iuka Pool

Spudding Date 8-9-51

Drlg. Data Oil well TD 4247

8" @ 397 Heeb. 3433 Br. lime 3657

KC 3669 Miss. 4062 Viola 4106

Simp. sh. 4183 Simp. sd. 4220-47

5½" @ 4238 CO to 4247 water PB 4243

12/ 4236-39 60/ 4226-36 S/ 104 bo 7 hr.

Hydrofrac TD 4247 F/ 41 bo 1 hr.

F/ 78 bo 6 hr. Comp. BHB 3000 bopd

J. E. TYRA