

KANSAS


Pratt

Section 6 Township 27 Range 12W

Well No. 1 Helmke "B"

Company Cities Service

Iuka Pool

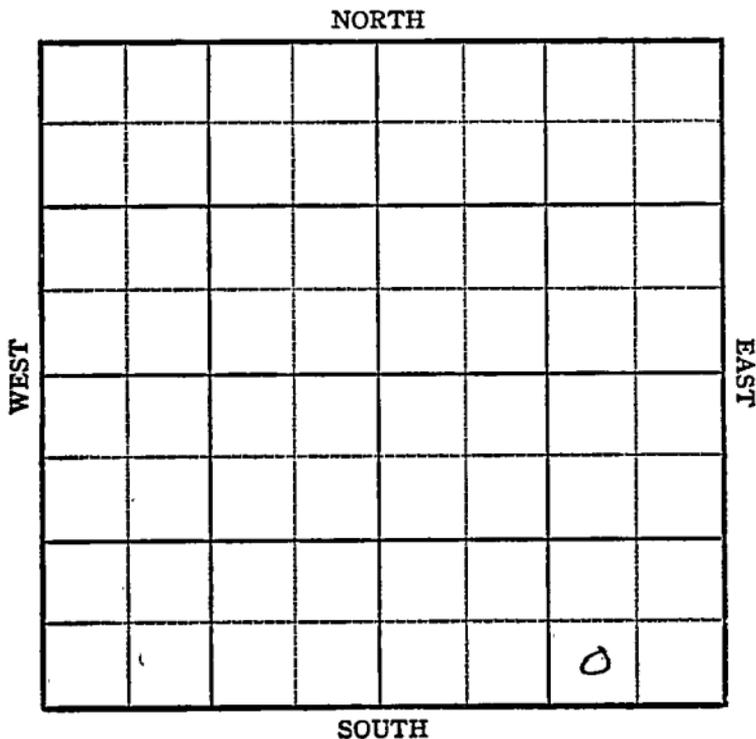

Pratt



KANSAS

Sec. 6 Twp. 27 R. 12W

Well No. #1 Helmke "B" Farm

Cities Service

Company

Iuka Pool


\_\_\_\_\_ Ft. from N. Line

330' Ft. from S. Line

990' Ft. from E. Line

\_\_\_\_\_ Ft. from W. Line

SW SE SE

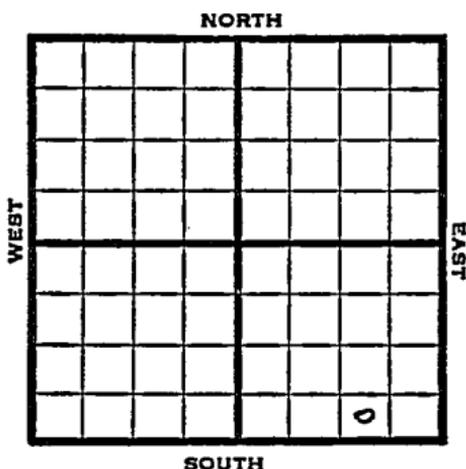

1948

Eli 1894' REPORT

- 10/20 Surface Hole
- 10/26 8" @ 421'
- 11/3 Drlg. 2020'
- 11/3 Drlg 402 1'
- 11/10 Lansing 3722'
- Miss 4134'
- Kind 4166
- Viola 4182
- Sim p Sd 4224
- TD 4249
- 5" @ 4242
- 11/16 Drlg. 4267'
- 11/23 Arb. 4327'
- 125' of 4" liner @ 4332'
- Drlg 4340'
- 11/30 PB 4272'
- 20 qts 4247-67
- CO
- 12/8 TD 4340'
- Arb. 4327'
- A<sub>1</sub>band.

**ABANDONED**

Map No. \_\_\_\_\_ Sec. 6 Twp. .27 R. 12W

Well No. 1 Helmke "B"

Cities Service Company

**FIRST REPORT**

Contractor \_\_\_\_\_

SW SE SE

**SECTION PLAT**

\_\_\_\_\_ Ft. from N. Line

330 Ft. from S. Line

990 Ft. from E. Line

\_\_\_\_\_ Ft. from W. Line


Pratt County

Location \_\_\_\_\_

Rig up \_\_\_\_\_

Drilling and Remarks:

surface hole

**RECORD**

Cased \_\_\_\_\_ in., \_\_\_\_\_ ft.

Sand \_\_\_\_\_

Gas \_\_\_\_\_

Oil \_\_\_\_\_

Total Depth \_\_\_\_\_

**PRODUCTION**

1st 24 hrs. Nat. \_\_\_\_\_

1st 24 hrs. after shot \_\_\_\_\_

Gas \_\_\_\_\_ Cu. Ft.

Dry Hole \_\_\_\_\_

Abandoned \_\_\_\_\_

Date

OCT 20 1948 19

S. J. LEWIS Scout

Map No. 510 Sec. 6 Twp. 27 R. 12W

Well No. 1 Helmke "B"

Cities Service

Company

ABANDONED

Contractor

SW SE SE

*ELIOTT*  
SECTION PLAT

\_\_\_\_\_ Ft. from N. Line

330 Ft. from S. Line

990 Ft. from E. Line

\_\_\_\_\_ Ft. from W. Line

			0

Pratt County

Location \_\_\_\_\_

Rig up \_\_\_\_\_

Drilling and Remarks:

*CR 4327*

RECORD

Cased \_\_\_\_\_ in., \_\_\_\_\_ ft.

Sand \_\_\_\_\_

Gas \_\_\_\_\_

Oil \_\_\_\_\_

Total Depth 4240

PRODUCTION

1st 24 hrs. Nat. \_\_\_\_\_

1st 24 hrs. after shot \_\_\_\_\_

Gas \_\_\_\_\_ Cu. Ft.

Dry Hole \_\_\_\_\_

Abandoned \_\_\_\_\_

Date

DEC 8 1948 19

S. J. LEWIS Scout