

KANSAS


FORM 51 5M 1-42 PETROL

Pratt

Section 6 Township 27 Range 12-W

Well No. #1 Helmke "C"

Company Skelly

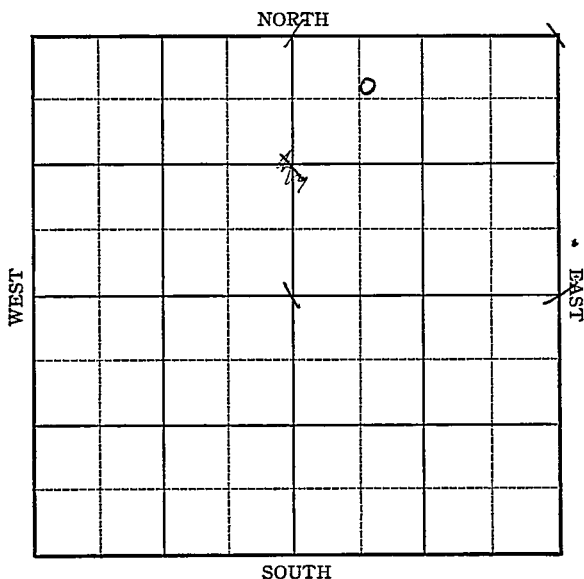

KANSAS

Pratt

Sec. 6 Twp. 27 R. 12-W

Well No. #1 Helmke "C" Farm

Skelly Company


Carmi

550 Ft. from N. Line

 Ft. from S. Line

 Ft. from E. Line

766 Ft. from W. Line

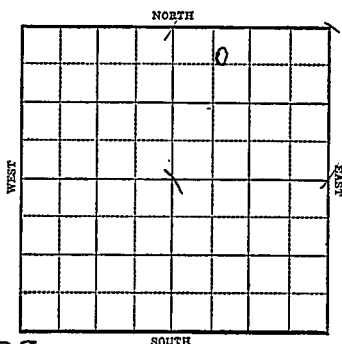

Elev. 1897

R E P O R T

1943

7/7 8" @ 448'

7/15 Drlg. 2245'

7/21 Drlg. 3610'

7/28 Lans 3711
Drlg. 4220'

8/4 Miss 4121
Viola 4153
Wimp 4232
Arb 4313-15 T.D.
5" @ 4313
RUST

8/11 "

8/18 Drlg. 4316'
1 gal oil per hr.

8/25 T.D. 4318-500 acid SO
1500 acid

9/1 PB 4275
71 shots 4210-21
750 acid
No test.

9/8 " "

9/15 PB 4217, 76 shots
4169-93 CO

9/22 3500 acid

OVER

1943

9/29 PB 3500 acid

10/6 " " "

10/13 " " "

10/20 Arb 4313

5" @ 4318

Water

T.D. 4318'

ABANDONED

KANSAS

Map No. 54 Sec. 6 Twp. 27 R. 12WWell No. 1 Helmke "C"Skelly

Company

FIRST REPORT

Contractor

C NW NE

550

Ft. from N. Line

Ft. from S. Line

Ft. from E. Line

766

Ft. from W. Line

SECTION PLAT

		0	

CARMI POOL

Location

Rig up

Drilling and Remarks:

8"-448'

RECORD

Cased _____ in., _____ ft.

Sand _____

Gas _____

Oil _____

Total Depth _____

PRODUCTION

1st 24 hrs. Nat. _____

1st 24 hrs. after shot _____

Gas _____ Cu. Ft.

Dry Hole _____

Abandoned _____


Date

JUL 7 1943

19

S. J. LEWIS

Scout

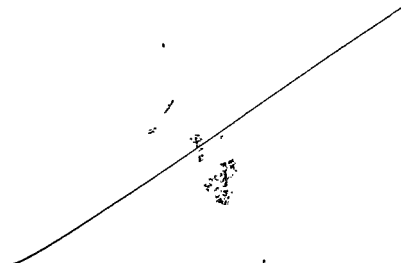

Misc Small Maps	<i>[Signature]</i>
Cards	<i>[Signature]</i>
Tracing	<i>[Signature]</i>
France Map	<i>[Signature]</i>
Scarborough Map	<i>[Signature]</i>
Moody Map	<i>[Signature]</i>
Geological Dist.	<i>[Signature]</i>
Moody Flat Book	

KANSASMap No. 57 Sec. 6 Twp. 27 R. 12WWell No. 1 Helmke "C"Skelly

Company

ABANDONED

Contractor

C NW NE

SECTION PLAT

550 Ft. from N. Line Ft. from S. Line Ft. from E. Line766 Ft. from W. Line

		o	,

Carmi PoolLocation Rig up

Drilling and Remarks:

Cery 43135" @ 4313Water

RECORD

Cased in., ft.Sand Gas Oil Total Depth 4318

PRODUCTION

1st 24 hrs. Nat. 1st 24 hrs. after shot Gas Cu. Ft.Dry Hole Abandoned


Date

OCT 20 1943

19

S. J. LEWIS

Scout

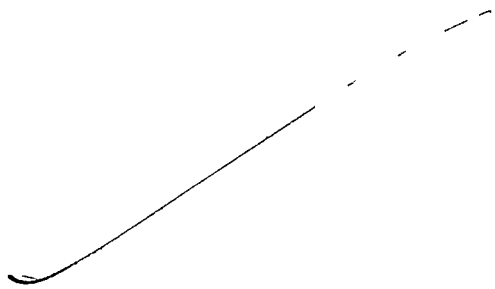

Misc. Small Maps	<i>Small</i>
Cards	<i>Madge</i>
Tracing	<i>Madge</i>
France Map	<i>✓</i>
Scarborough Map	<i>✓</i>
Pierce Map	<i>✓</i>
Geological Dept.	
Pierce Map	