

Section 6 Township 27 Range 12W

Well No. 1 Helmke "H"

Company Skelly

Carmi Pool

NORTH

							0

WEST

EAST

SOUTH

KANSAS

Pratt

Sec. 6 Twp. 27 R. 12W ✓

Well No. #1 Helmke "H" Farm

Skelly

Company

Carmi Pool


330' Ft. from N. Line

\_\_\_\_\_ Ft. from S. Line

330' Ft. from E. Line

\_\_\_\_\_ Ft. from W. Line

NE/C

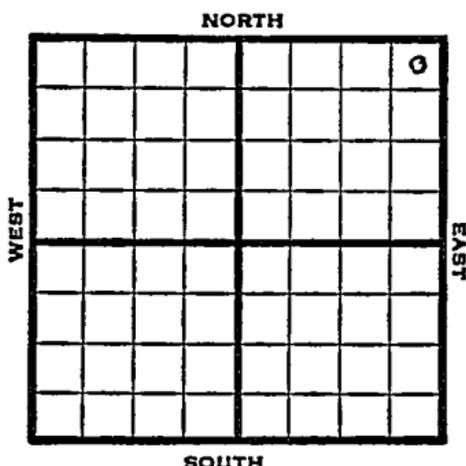

1948

Elev. 1902' REPORT

10/20

8" @ 443'  
Drlg. 1664'

10/26

Drlg. 3960'

11/3

Lansing 3699'

Miss 4121'

Viola 4158'

Simpson 4197'

TD 4224

5" @ 4209'

11/10

1000 acid

11/16

TD 4254'  
40 qts 4224-54  
CO

11/23

TD 4326'  
300 acid

11/30

25 bbls oil & 4 W 24 hrs.

12/6

"

12/14

"

12/22

"

12/29

"

1949

1/5

Arb. 4300'  
5" @ 4209'  
Pump 26 oil & 20% W Pot.  
Gr. 40.7°  
TD 4326'

COMPLETED

Map No. \_\_\_\_\_ Sec. 6 Twp. 27 R. 12W

Well No. 1 Helmke "H"

Skelly Company

FIRST REPORT Contractor

NE/C

SECTION PLAT

330 Ft. from N. Line

\_\_\_\_\_ Ft. from S. Line

330 Ft. from E. Line

\_\_\_\_\_ Ft. from W. Line

			0

Pratt County

Location \_\_\_\_\_

Rig up \_\_\_\_\_

Drilling and Remarks:

8" @ 443

drlg. 1664

RECORD

Cased \_\_\_\_\_ in., \_\_\_\_\_ ft.

Sand \_\_\_\_\_

Gas \_\_\_\_\_

Oil \_\_\_\_\_

Total Depth \_\_\_\_\_

PRODUCTION

1st 24 hrs. Nat. \_\_\_\_\_

1st 24 hrs. after shot \_\_\_\_\_

Gas \_\_\_\_\_ Cu. Ft.

Dry Hole \_\_\_\_\_

Abandoned \_\_\_\_\_

Date

OCT 20 1948 19

S. J. LEWIS Scout

NAME OF DONOR

ADDRESS

CITY

STATE

SECTION 1


1. Name of Donor

2. Address

3. City

4. State

SECTION 2

- Misc. Small Maps
- Cards
- Tracing
- France Map
- Scarborough Map
- Pierce Map
- Geological Dept.
- Pierce Plat Book

Map No. 54 Sec. 6 Twp. 27 R. 12W

Well No. I Helmke "H"

Skelly Company

**COMPLETE** Contractor

*E 11902*

NE/C

**SECTION PLAT**

330 Ft. from N. Line

         Ft. from S. Line

330 Ft. from E. Line

         Ft. from W. Line

			0

Pratt County

Location                                 

Rig up                                 

Drilling and Remarks:

*CR 4300*

*5" C 4209*

*Run 26 oil + 20%*

*Pat*

*4 1/2 Sec*

**RECORD**

Cased          in.,          ft.

Sand                                 

Gas                                 

Oil                                 

Total Depth 51926

**PRODUCTION**

1st 24 hrs. Nat.                         

1st 24 hrs. after shot                         

Gas                                  Cu. Ft.

Dry Hole                                 

Abandoned                                 

Date

JAN 5 1949 19

S. J. LEWIS Scout

