



Pratt

KANSAS

Sec. 6 Twp. 27 R. 12 ~~W~~

Well No. # 2 Beck "B" Farm \_\_\_\_\_

CRA Company \_\_\_\_\_

Contractor \_\_\_\_\_

Iuka Pool


Ft. from N. Line \_\_\_\_\_

330 Ft. from S. Line \_\_\_\_\_

330 Ft. from E. Line \_\_\_\_\_

Ft. from W. Line \_\_\_\_\_

SE SE SW

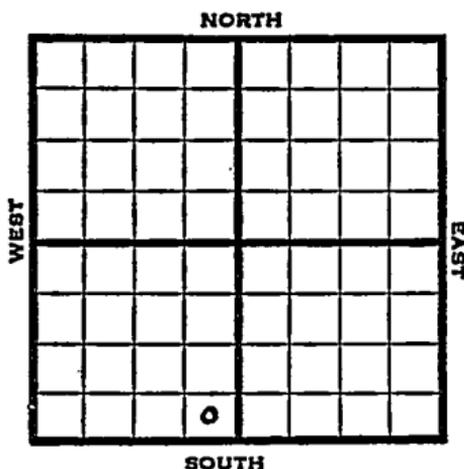

1951 Elv. 1847' REPORT

3/7 Spud 3-4-51  
8" @ 346  
Drilling 370'

4/4 Spud 3-4-51  
Oil Well TD 4264  
8" @ 346'  
Heeb. 3450 Br lime 3669  
Lans 3689'  
DST 3841-3901 opn 1/2 hr  
Rec. 120' hgcm  
Simp. 4190' Dol. 4207  
Sand 4218-62 Miss 4071  
Kinderhook 4098 Viola 4111  
TD 4262 F/112 bo 2 1/2 hr  
F/95 bo 2 hr Comp. 476 bopd  
24/62" choke CP 300# TP 150#

**COMPLETED**



Scout Cards *mm* MAR 9 1951  
Land Small Map  
Land Wall Map  
Tracings  
France Map  
Pierce Map  
Misc.

Orig. Date



Scout Cards .....  
Land Small Map .....  
Land Wall Map .....  
Tracings .....  
France Map .....  
Pierce Map .....  
Misc. ....

APR 10 1951