

Section _____ Township _____ Range _____


Well No. # 4 Helmke (J) _____

Company Skelly Oil _____

NORTH

WEST

EAST

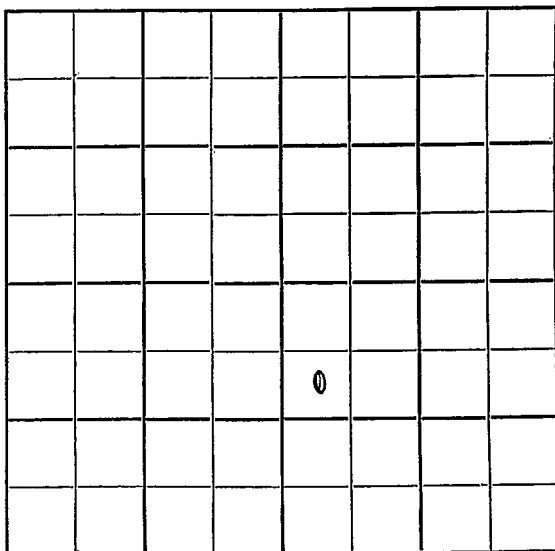

SOUTH

Pratt

6

27

KANSAS
12 W ✓

Sec. _____ Twp. _____ R. _____

Well No. # 4 Helmke (J) _____ Farm _____

Skelly Oil _____ Company _____

Carmi Pool _____ Contractor _____


990 _____ Ft. from N. Line

_____ Ft. from S. Line

_____ Ft. from E. Line

330 _____ Ft. from W. Line

SW NW SE

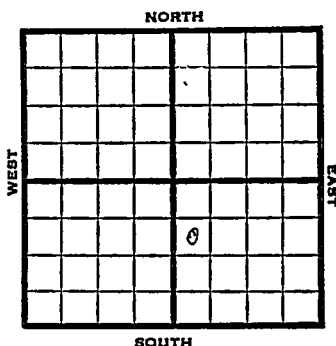

1951 Elev. 1869' REPORT

7/11 Spud 7-6-51
8" @ 414

8/29 Spud 7-6-51
Oil well TD 4259' 8" @ 414
Heelg. 3435' Doug. 3530' Br. lime
3650', Lans. 3665' Miss. 4062'
Kh. 4083' Viola 4110' Simp. sh.
4187', Simp. dol. 4210' Simp.
sand 4216'
TD 4259' 5" @ 4214 S/221 BO 1½ BW
18 hr. PB 4253' 80 qt/4220-53
F/201 BOPD
Comp. 143 BOPD

COMPLETED

County Pratt State Kansas
 Sec. 6 (Blk.) 27 (Sur.) 12W Map No.
 Operator Skelly Oil
 Well No. 4 Farm Helmke (J)
 Elev. _____ Location SW NW SE

FIRST REPORT

0

990 Ft. From N Line SE
330 Ft. From W Line Quarter

1st. Report JUL 11 1951

Completion _____

Remarks _____

Spudding Date 7-6-51


Drlg. Data _____

Carmi - pool

8" @ 414

J. E. TYRA

County Pratt State Kansas
 Sec. 6 (Blk. 27) (Sur. 12W) Map No. _____
 Operator Skelly Oil
 Well No. 4 Farm Helmke "J"
 Elev. 1869 Location SW NW SE

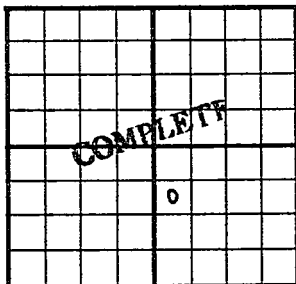

990 Ft. From N Line SE
330 Ft. From W Line Quarter

1st. Report _____

Completion AUG 29 1951

Remarks Carmi Pool

Spudding Date 7-6-51

Drlg. Data Oil well TD 4259
8" @ 414 Heeb. 3435 Doug. 3530
Br. lime 3650 Lans. 3665 Miss. 4062
Kh. 4083 Viola 4110 Simp. sh. 4187
Simp. dol. 4210 Simp. sand 4216 TD 4259
5" @ 2214 S/ 221 bo $1\frac{1}{2}$ bw 18 hr.
PB 4253 80 qt/ 4220-53 F/ 201 bopd
Comp. 143 bopd

J. E. TYRA