

Section 6 Township 27 Range 12 W

Well No. # 3 Helmke "J"

Company Skelly Oil

NORTH


WEST

EAST

SOUTH

Pratt

KANSAS

Sec. 6 Twp. 27 R. 12 W ✓

Well No. # 3 Helmke "g" Farm \_\_\_\_\_

Skelly Oil Company

Contractor \_\_\_\_\_

Iuka Pool


\_\_\_\_\_ Ft. from N. Line

660 Ft. from S. Line

\_\_\_\_\_ Ft. from E. Line

990 Ft. from W. Line

C E L SW SE

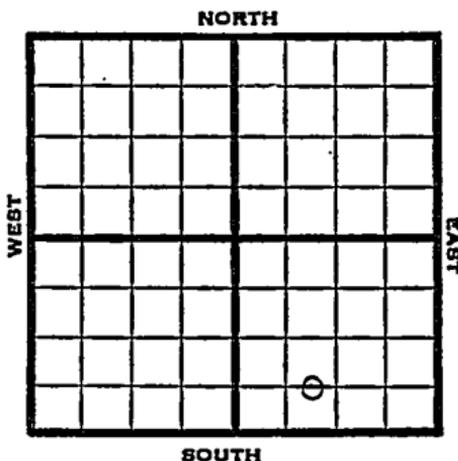

1951

Elev. 1873' REPORT

5/29

Location

8/1

Spud 6-14-51

Oil Well TD 4261

8" @ 453 Heeb. 3530

Doug 3640 Br Lime 3667

Lans. 3689 Miss 4078

Kh 4103 Viola 4122

Simp sh 4194

Dol. 4211 Sd 4218

TD 4261 5" @ 4218

F/92 bo 21 hr 84/qt 4228-61

F/406 bopd 1,460,000 gas Comp.

**COMPLETED**



