
FORM 51 25M 8-50 WESTERN Pratt KANSAS

Section 6 Township 27 Range 12W

Well No. 5 Helmke "J"

Company Skelly Oil

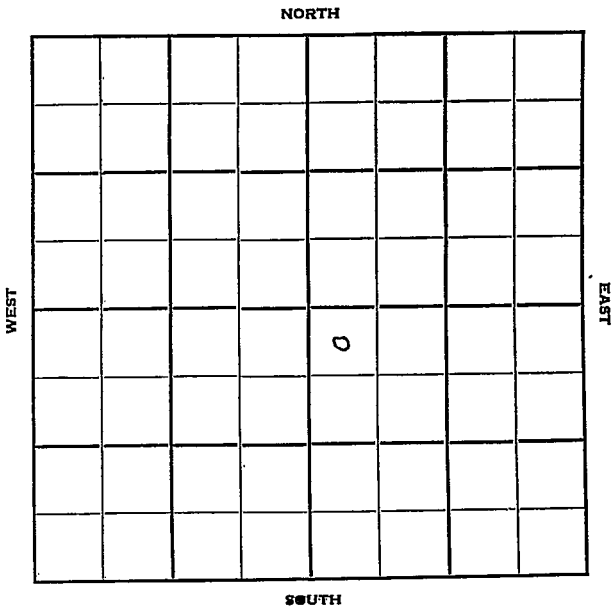

FORM 252-B
10M 11-50 PETROL

Pratt KANSAS

Sec. 6 Twp. 27 R. 12W

Well No. #5 Helmke "J" Farm

Skelly Oil Company

Contractor

Iuka Pool


330' Ft. from N. Line

Ft. from S. Line

Ft. from E. Line

330' Ft. from W. Line

NW NW SE

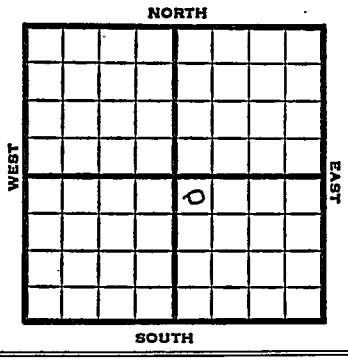

1951	Elev. 1875' REPORT
8/1	Spud 7-29-51 8" @ 427'
11/14	Spud 7-29-51 Oil Well TD 4270 8" @ 427 Doug. 3548 Br. Lime 3659 Lans. 3679 Miss. 4063 Kh. 4089 Viola 4105 Simp. sh. 4191 Simp. Sd. 4225 Cored 4210-65 Rec. 55' TD 4265 5" @ 4210 DC 4265 S/ 24 bopd 50 qt./ 4221-27 pipe collapsed set whipstock @ 2350 Lans. 3682 Miss. 4065 Kh. 4091 Viola 4107 Simp. 4194 Dolo. 4208 Sand 4227 5" @ 4270 CO to 4267 32/ 4250-58 Hydra. S/ 3 BW 9 hr. PB 4244 36/ 4233-42 38 GO 12 GWPH Hydra S/ 4 BO 8 hr. PB 4230 20/ 4222-27 Hydra S/ 115 BOPD PB 4218 28/ 4205-12 Hydra F/ 133 BO 12 hr. Comp. F/ 246 BOPD 52 BW **COMPLETED**

FORM 275 FOR SALE BY KANSAS BLUE PRINT CO.


County Pratt State Kansas

Sec. 6 (Blk. Twp.) 27 (Sur. Rge.) 12W Map No.

Operator Skelly Oil

Well No. 5 Farm Helmke "J"

Elev. Location NW NW SE

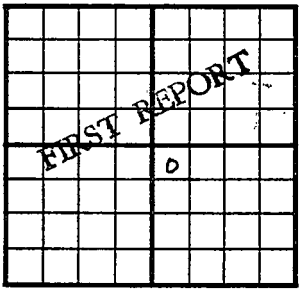

330 Ft. From N Line SE

330 Ft. From W Line Quarter

1st. Report AUG 1 1951

Completion

Remarks

Spudding Date 7-29-51

Drlg. Data Iuka Pool

8" @ 427

J. E. TYRA

FORM 275 FOR SALE BY KANSAS BLUE PRINT CO.


County Pratt State Kansas

Sec. 6 (Blk. Twp.) 27 (Sur. Rge.) 12W Map No.

Operator Skelly Oil

Well No. 5 Farm Helmke "J"

Elev. 1875 Location NW NW SE

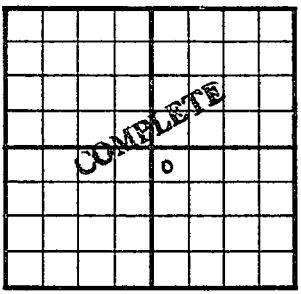

330 Ft. From N Line SE

330 Ft. From W Line Quarter

Ist. Report

Completion NOV 14 1951

Remarks Iuka Pool

Spudding Date 7-29-51

Drlg. Data Oil well TD 4270

8" @ 427 Doug. 3548 Br. lime 3659

Lans. 3679 Miss. 4063 Kh. 4089

Viola 4105 Simp. sh. 4191 Simp. sd. 4225

Cored 4210-65 Rec. 55' TD 4265

5" @ 4210 DC 4265 S/ 24 bopd

50 qt/ 4221-27 pipe collapsed set

whipstock @ 2350 Lans. 3682 Miss. 4065

Kh. 4091 Viola 4107 Simp. 4194

Dol. 4208 Sand 4227 5" @ 4270

CO to 4267 32/ 4250-58 Hydro. S/ 8 bw

9 hr. PB 4244 36/ 4233-42 38 go

12 gwph Hydro. S/ 4 bo 8 hr. PB 4230

20/ 4222-27 Hydro. S/ 115 bopd PB 4218

28/ 4205-12 Hydro. F/ 133 bo 12 hr.

Comp. F/ 246 bopd 52 bw

J. E. TYRA