


Section 6 Township 27 Range 12W

Well No. #6 Helmke (J)

Company Skelly Oil

NORTH

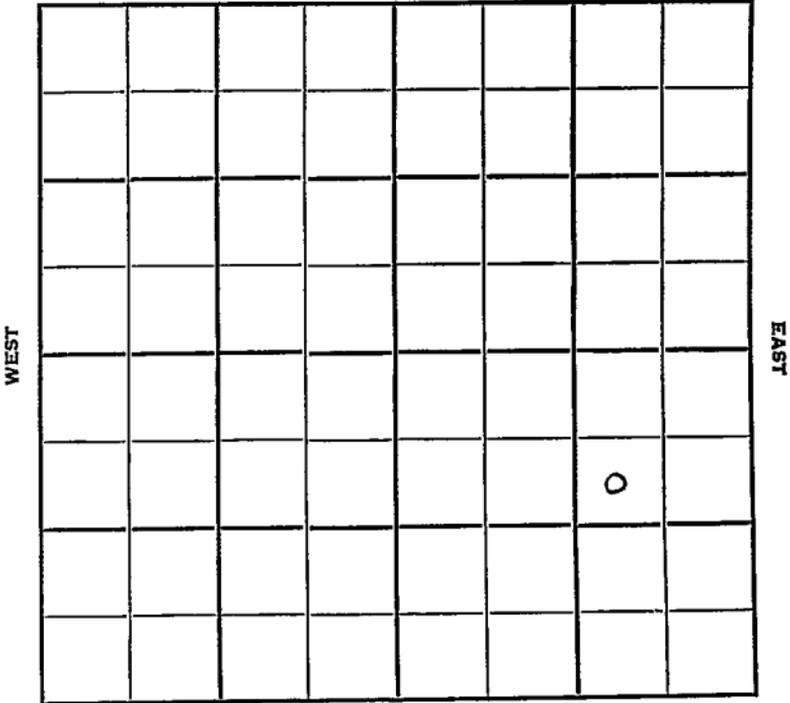

SOUTH

Sec. 6 Twp. 27 R. 12W

Well No. #6 Helmke (J) Farm

Skelly Oil Company

Inka Contractor


990 Ft. from N. Line

_____ Ft. from S. Line

990 Ft. from E. Line

_____ Ft. from W. Line

SW NE SE

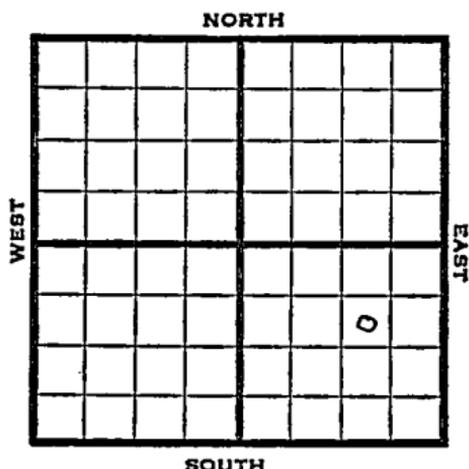

1951 Elev. 1890' REPORT

10/31 Spud 10-25-51
8" @ 460' WOC

1952
1/23 Spud 10-25-51
Oil well TD 4277
8" @ 460
Heeb. 3507 Doug. 3564 Br Li 3679
Lans. 3693 Miss. 4076 Kh 4097
Viola 4120 Simp. sh. 4206
Dolo. 4222 Simp. sd 4235 TD 4277
5" @ 4277 24/ 4257-63 Hydro.
S/ 10 BW. 8 hr. CO to 4253 52/ 4235-48
Hydro. S/ 29 BW 32 hr. CO to 4232
26/ 42222-29 Hydro. S/ 1/4 BWPB
3000 A S/ 11 BWPB CO to 4214
52/ 4182-95 Hydro S/ 19 BO 6 BWPB
Comp. 73 BOPD

COMPLETED

