


Section 6 Township 27 Range 12W

Well No. #2 McFadden "C"

Company C R A

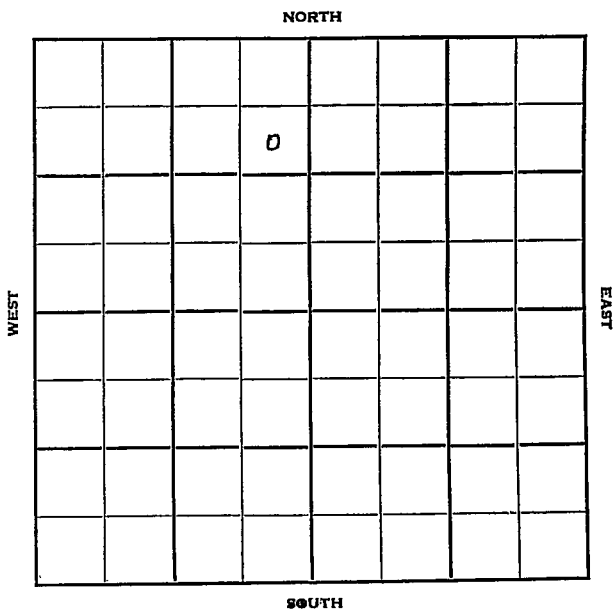

Pratt

KANSAS

Sec. 6 Twp. 27 R. 12 W

Well No. # 2 McFadden "C" Farm

C. R. A. Company

Wakefield. Contractor

Iuka - Carmi Pool


990 Ft. from N. Line

\_\_\_\_\_ Ft. from S. Line

330 Ft. from E. Line

\_\_\_\_\_ Ft. from W. Line

SE NE NW

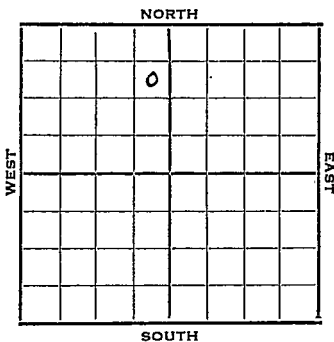

1951 Elev. 1888' REPORT

11/21 Spud 11-19-51  
8" @ 370'

1952  
1/16 Spud 11-19-51  
Oil well TD 4258' 8" @ 370  
Lans. 3687'  
DST 3790-3857' open 1 hr, rec 610'  
SW Heeb 3439' Br. line 3672'  
KC 3685' Miss 4068' Kh. 4094'  
Viola 4113' Simp. sh. 4190'  
Simp. dol. 4210' Simp. sd 4222'  
TD 4258' 5" @ 4257' CO to 4256'  
144/4232-56 F/17 BO 1 hr. Hydro  
F/447 BOPD  
Comp. BHB 2144 BOPD

**COMPLETED**

County Pratt State Kansas

Sec. 6 (Blk. Twp.) 27 (Sur. Rge.) 12W Map No.

Operator G R A

Well No. 2 Farm McFadden "C"

Elev. Location SE NE NW

		0			

990 Ft. From N Line NW

330 Ft. From E Line Quarter

1st. Report NOV 21 1951

Completion

Remarks

Wakefield - Contr.

Spudding Date 11-19-51

Inka - Carmi Pool

Drlg. Data

8" @ .370

