
FORM 51 25M 8-50 WESTERN O.W.D.D Pratt KANSAS

Section 6 Township 27 Range 12 W

Well No. # 3 McFadden (C)

Company Cooperative Refinery Assoc.

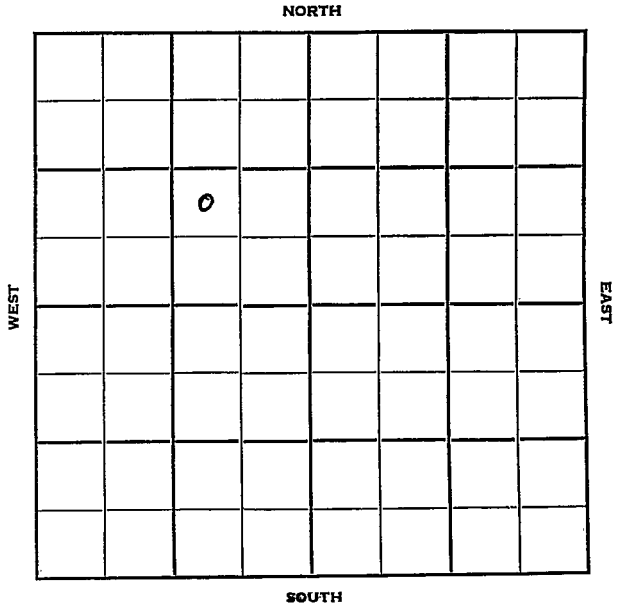

FORM 252-B
10M 8-51 TPCO.

Pratt

KANSAS

Sec. 6 Twp. 27 R. 12W

Well No. #3 McFadden (C) Farm

Cooperative Refinery Assoc. Company

Contractor

Yuka


Ft. from N. Line

990' Ft. from S. Line

990' Ft. from E. Line

Ft. from W. Line

NW SE NW

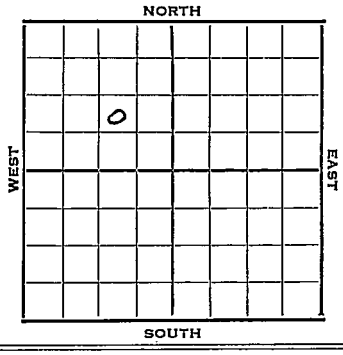

1951	Elev. 1886' REPORT
12/19	RUR
1952	
2/6	TD 4270 5" @ 4265 PB 4256 60/4245-55 HFW Sq off
2/13	CO to 4253 30/ 4233-43 S/ 8 BWPH, sq. off
2/20	DD to 4269 B/1½ BO & 8 gal wtr 1 hr. to hydra.
3/5	NR
3/12	"
3/19	"
4/2	Spud 12-20-51 D&A TD 4269 8" @ 460 Heeb. 3440 Br Li 3668 Lans. 3680 DST 3792-3822 open 15 min. rec. 85' mud DST 397-15 open 1 hr. rec. 85' GCM & tr. oil Miss. 4066 Kh. 4097 Viola 4144 Simp. sh. 4195 Simp. sd 4236 5" @ 4265 DD 4266 FU 250' oil 1 hr. DD 4270 F 45 bo 3 hr. Hydro S/ 7 boph PB 4260

OVER

1952

4/2 60/ 4249-59 HFW CO to 4257
30/ 4237-47 S/ 8 bwph DD 4269
B/ ½ bo 8 gwph S/ 50 bo
went to all wtr.
D&A

ABANDONED

O.W.D.D

1952

12/23 Oil Well
TD 4285'
Lans 3680, Miss 4066, Kh 4097,
Viola 4144, Simp sh 4195,
Simp. sd 4236
OTD 4270
5" @ 4265
DD 4285
Arb 4284
FU 200' fluid, mostly wtr.
PB 4203
104/4166-90, S/3 bfph 6 hrs.
PB 4152 95/4124-48 A-frac
Comp. 20 BOPD

FIRST REPORT

COMPLETED

FORM 275 FOR SALE BY KANSAS BLUE PRINT CO.


County Pratt State Kansas

Sec. 6 (Blk. / Twp.) 27 (Sur. / Rge.) 12W Map No.

Operator Cooperative Refinery Assoc.

Well No. 3 Farm McFadden (C)

Elev. Location NW SE NW

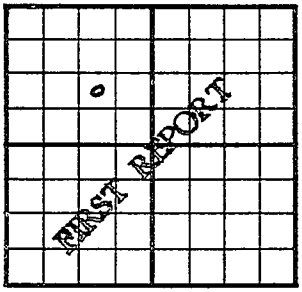

990 Ft. From S Line NW

990 Ft. From E Line Quarter

1st. Report DEC 1 9 1951

Completion

Remarks

Spudding Date

Drlg. Data Tuka

RUR

J. E. TYRA

Scout Cards
Land Small Map
Land Wall Map
Tracings
France Map
Pierce Map
Misc.

DEC 31 1951

Drlg. Data

FORM 275 FOR SALE BY KANSAS BLUE PRINT CO.


County Pratt State Kansas

Sec. 6 (Blk. Twp.) 27 (Sur. Rge.) 12W Map No.

Operator Cooperative Refinery Assoc.

Well No. 3 Farm McFadden "C"

Elev. 1886 Location NW SE NW

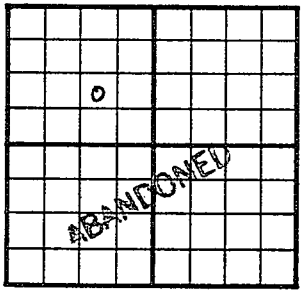

990 Ft. From S Line NW

990 Ft. From E Line Quarter

1st. Report

Completion APR 2 1952

Remarks Iuka Pool

Spudding Date 12-20-51

Drlg. Data D & A TD 4269

8" @ 460 Heeb. 3440 Br. lime 3668

Lans. 3680 DST 3792-3822 open 15 min.

Rec. 85' mud DST 3907-15 open 1 hr.

Rec. 85' gcm & tr. oil Miss. 4066

Kh. 4097 Viola 4144 Simp. sh. 4195

Simp. sd. 4236 5" @ 4265 DD 4266

FU 250' oil 1 hr. DD 4270 F/ 45 bo

3 hr. Hydro. S/ 7 boph PB 4260

60/ 4249-59 HFW CO to 4257 30/ 4237-47

S/ 8 bwph DD 4269 B/ ½ bo 8 gwph

S/ 50 bo went to all water

D & A

J. G. McGEHEE

Scout Cards .....
Land Small Map .....
Land Wall Map .....
Tracings .....
France Map .....
Pierce Map .....
Misc. .....

APR 8 1952

Drlg. Data

FORM 275 FOR SALE BY KANSAS BLUE PRINT CO.

O.W.D.D


County Pratt State Kansas

Sec. 6 (Blk. Twp.) 27 (Sur. Rge.) 12W Map No.

Operator C R A

Well No. 3 Farm McFadden "C"

Elev. 1890 Location NW SE NW

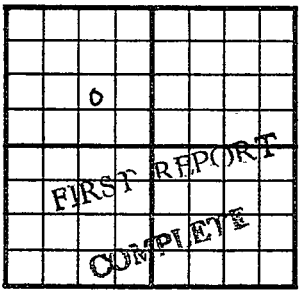

990 Ft. From S Line NW

990 Ft. From E Line Quarter

1st. Report DEC 23 1952

Completion DEC 23 1952

Remarks

O.W.D.D

Spudding Date

Drlg. Data Oil well TD 4285

Lans. 3680 Miss. 4066 Kh. 4097

Viola 4144 Simpl sh. 4195 Simp. sd. 4236


QTD 4270 5" @ 4265 DD 4285 Arb. 4284

FU 200' fluid mostly wtr. PB 4203

104/ 4166-90 S/ 3 bfph 6 hr. PB 4152

95/ 4124-48 A-frac Comp. 20 bopd

J. G. McGEHEE

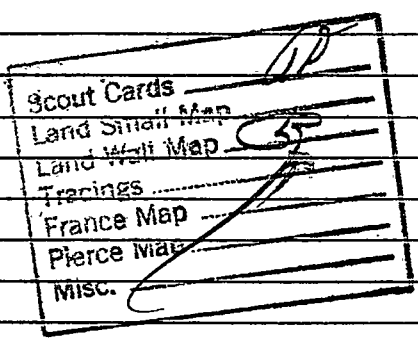
DEC 29 1952
Scout Cards
Land Small Map
Land Wall Map
Tracings
France Map
Pierce Map
Misc.

Drlg. Data