

Pratt

KANSAS

6

27

12W

Section _____ Township _____ Range _____

Well No. 7 McFadden "C"

Company CRA

NORTH

WEST

EAST

SOUTH

Pratt

Sec. 6 Twp. 27 R. 12WWell No. #7 McFadden "C" FarmC R A


Company

Hulme

Contractor

330 Ft. from N. Line Ft. from S. Line Ft. from E. Line990 Ft. from W. Line

NE NW NW

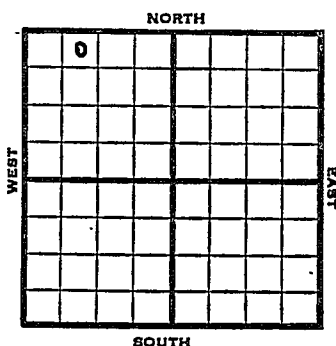

1953 Elev. 1907' REPORT

2/4 Spud 2-2-53
Drlg. 1250'

2/12 8" @ 470
Drlg. 3860

2/19 Heeb 3456, Br 1i 3692, Lans
3714, Miss 1i 4059, SO 3725-27
& 3746-53,
V 4125, Simp 4208
Ø 4226-71 full rec.
Ø 4276-85

2/26 RTD 4287 5" @ 4286½ C.O.

3/12 CO

3/19 "

3/26 "

4/1 Spud 2-2-53 Oil well TD 4287'
8" @ 470 Heeb 3456 Br 1i 3692'
Lans. 3714 SO 3725-37 3746-53
Miss 4059 Viola 4125 Simp 4208
TD 4287 5" @ 4286½ CO to 4285
16/4274-82 SSO B/55 GW scum oil 8 hr
PB 4280 40/4240-50 sd-Oil-fraw
SP 4260 15 GWPH CO to 4287 13 GO
4 GW 4 hr. Hydro. 161 BO 12 hr.
Comp. 77 BOPD 10 BW

COMPLETED

County **Pratt** State **Kansas**

Sec. 6 (Blk. 27 (Sur. 12W Map No.

Operator **C R A**

Well No. **7** Farm **McFadden "C"**

Elev.	Location	NE	NW	NW
-------	----------	----	----	----

0

FIRST REPORT

330 Ft. From N Line NW

990 Ft. From W Line Quarter

1st. Report FEB 4 1953

Completion

Remarks

Hulme - Contr.

Spudding Date 2-2-53

Drlg. Data

drlg. 1250

County Pratt State KansasSec. 6 (Blk.
Twp.) 27 (Sur.
Rge.) 12W Map No.Operator C R AWell No. 7 Farm McFadden "C"Elev. 1907 Location NE NW NW

0						

330 Ft. From N Line NW990 Ft. From W Line Quarter

1st. Report

Completion APR 1 1953

Remarks

Hulme - Contr.Spudding Date 2-2-53Drlg. Data Oil well TD 42878" @ 470 Heeb. 3456 Br. lime 3692Lans. 3714 SO 3725-37 3746-53Miss. 4059 Viola 4125 Simp. 4208TD 4287 5" @ 4286 $\frac{1}{2}$ CO to 428516/ 4274-82 SSO B/ 55 gw scum oil 8 hrPB 4280 40/ 4240-50 sd-oil-fracSP 4260 15 gwph CO to 4287 13 go4 gw 4 hr. Hydro. 161 bo 12 hr.Comp. 77 bopd 10 bw

J. G. McGEHEE