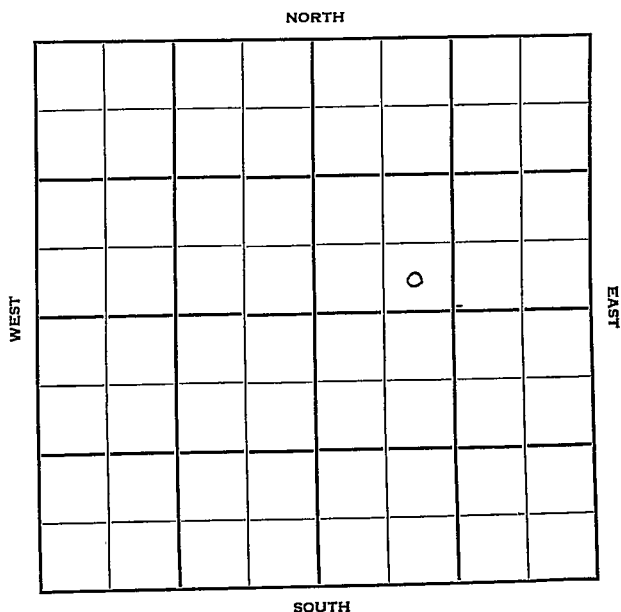


KANSAS

Pratt

Section 7 Township 27 Range 12-WWell No. #3 Helmke "B"Company Skelly Oil

Pratt

KANSAS

Sec. 7 Twp. 27 R. 12W ✓

Well No. #3 Helmke "B" Farm

Skelly Oil Company

Carmi Pool Contractor

 Ft. from N. Line

330'


 Ft. from S. Line

 Ft. from E. Line

990'

 Ft. from W. Line

SE SW NE

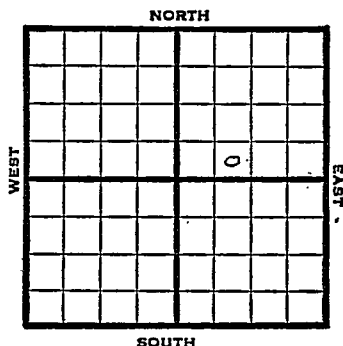

1950

Elev 1881

REPORT

6/21

Spud 6-17-50

8" @ 465'

WOC

7/26

8" @ 465

Heeb 3440

Miss 4106

Viola 4148

TD 4252

F/275 bo 6 hr

Comp E/333 bopd

Completed

Lans 3697

Kinderhook 4128

Simp 4200


COMPLETED

Kansas

Map No. _____ Sec. 7 Twp. 27 R. 12WWell No. 3 Helmke "B"_____
Skelly Oil _____ Company_____
Contractor

SE SW NE

SECTION PLAT

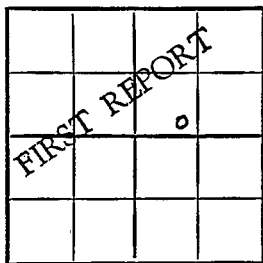Ft. from N. Line330 Ft. from S. Line_____
Ft. from E. Line990 Ft. from W. Line_____
Pratt County

Location _____

Rig up _____

Drilling and Remarks: /

Spud 6-17-50

8" C 465

WOC

RECORD

Cased _____ in., _____ ft.

Sand _____

Gas _____

Oil _____

Total Depth _____

PRODUCTION

1st 24 hrs. Nat. _____

1st 24 hrs. after shot _____

Gas _____ Cu. Ft.

Dry Hole _____

Abandoned _____

Date

JUN 21 1950 19J. E. TYRA Scout

1950








 









Scout Cards

Land Small Map

Land Wall Map

Tracings

France Map

Pierce Map

Misc

JUN 23 1950

Kansas

Carmi Pool

Map No. _____ Sec. 7 Twp. 27 R. 12WWell No. 3 Helmke "B"

_____ Skelly Oil _____ Company

_____ Contractor
SE SW NEE1. 1881
SECTION PLAT


_____ Ft. from N. Line

330 Ft. from S. Line

_____ Ft. from E. Line

990 Ft. from W. Line

Pratt County

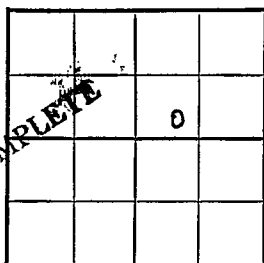

Location _____

Rig up _____

Drilling and Remarks:

8" @ 465

Heeb. 3440

Lans. 3697

Miss. 4106

Kinderhook 4128

Viola 4148

Simp. 4200

RECORD

Cased _____ in., _____ ft.

Sand _____

Gas _____

Oil _____

Total Depth 4252

PRODUCTION

1st 24 hrs. Nat. _____

1st 24 hrs. after shot _____

Gas _____ Cu. Ft.

Dry Hole _____

Abandoned _____

Date

JUL 26 1950 19J. E. TYRA Scout


100-440000-000000





 






JUL 31 1950

Scout Cards	7W
Land Small Map	
Land Wall Map	5
Tracings	
France Map	
Pierce Map	
Misc.	

Comp. F/ 333 bold

F/ 275 bo 6 hr

LD 4252