


Section 7 Township 27 Range 12W

Well No. #2 Diestler

Company Cities Service

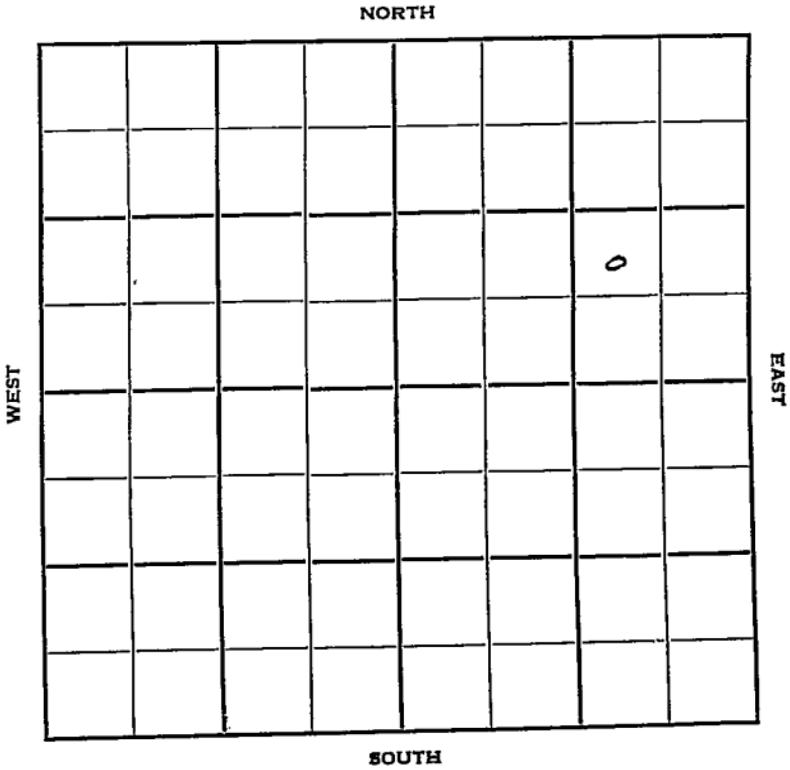

Sec. 7 Twp. 27 R. 12W

Well No. #2 Diestler Farm

Cities Service

Company

Contractor

Tuka Pool

Ft. from N. Line

825'


Ft. from S. Line

990'

Ft. from E. Line

Ft. from W. Line

NW SE NE

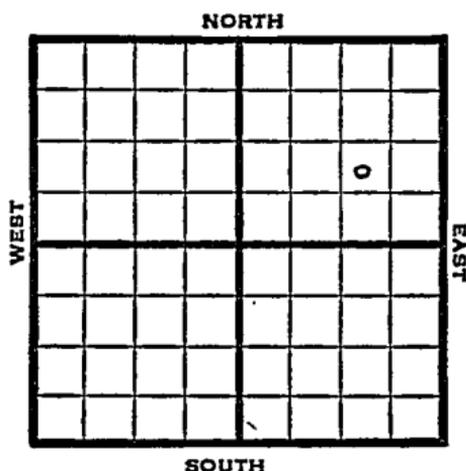

1950

Elev 1883 REPORT

10/4

Location

11/22

Spud 10-3-50

8" @ 405

Lans 3708

Miss 4123

Simp 4214

Simp dol 4238-41

5" @ 4242

TD4271

16 goph

500 A

no inc

TD 4280

FU 1690' oil 17 hr

S/30 bo 15 hr

DD 4290

30 qt/4252-82

F/50 bopd

S/81 bopd

Comp 81 bopd

TD 4290

Completed

**COMPLETED**



