


Section 7 Township 27 Range 12W

Well No. #4 Luders "B"

Company Skelly Oil

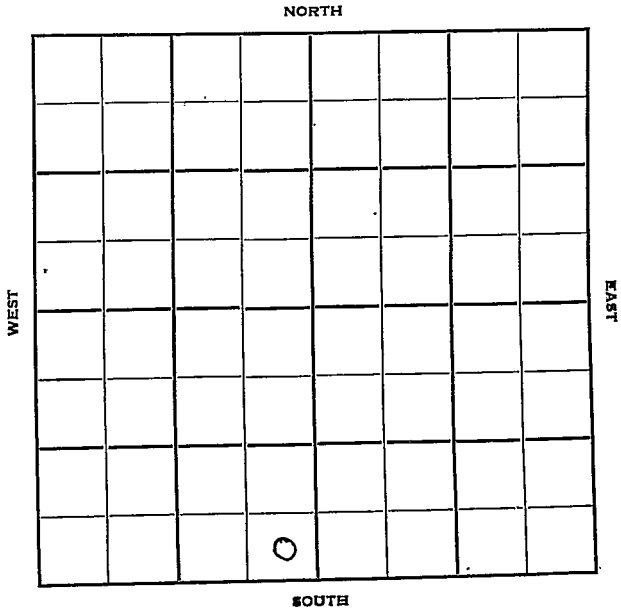

Sec. 7 Twp. 27 R. 12 W

Well No. # 4 Luders "B" Farm

Skelly Oil Company

Contractor


Ft. from N. Line

330 Ft. from S. Line

330 Ft. from E. Line

Ft. from W. Line

SE SE SW

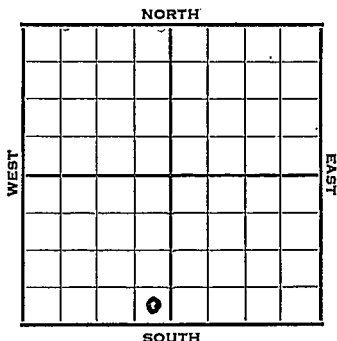

1952 Elev. 1852' REPORT

- 11/5 Spud 10-30-52*
8" @ 449
Drlg. 1195'
- 11/12 Drlg. 3485'
- 11/20 Br li 3649' Lans. 3669' Miss 4109'
V 4157' Simp sha 4199' Simp Dolo
4215'
Drlg. 4224'
- 11/27 Simp sd 4226
Drlg. 4272'
- 12/4 "
- 12/11 RTD 4284 5" @ 4283 DP 4284 12/4276-80
FW 250 Wtr Sq.
- 12/18 PB 4273 84/4225-37 HYL
- 12/25 " " "
- 1/1 TESTING
- 1/8 Testing
- 1/22 "
- 1/29 "

OVER

#4 Luders "B"

1953

2/4 Spud 10-30-52
Oil Well
TD 4284
8" @ 449
Br lime 3649, Lans 3669, Miss
4109, Viola 4157, Simp sh 4199,
Simp. dol. 4215, Simp. sd 4226
TD 4284,
5" @ 4283
DP 4284, 12/4276-80, FU 250# wtr.
PB 4273
84/4225-37, Hydro
S/3 bo 15 bwph SP 4280
24/4270-74 Hydro
S/1½ bwph 10 hrs.
PB 4265, 57/4250-58, Hydro
S/3 bwph
PB 4195, 132/4154-76 8 bo 12 hrs.
D-Hydro
P/30 bo 10 hrs.
Comp. 143 bopd

COMPLETED

Scout Cards	mm
Land Small Map	
Land Wall Map	33
Tracings	
Insects	
Pictures	
Misc.	

NOV 7 1952

Orig. Date

FEB 10 1952

Scout Cards	_____
Land Small Map	_____
Land Wall Map	_____
Tracings	_____
France Map	_____
Pierce Map	_____
Misc.	_____

Drig. Data