


Section 7 Township 27 Range 12-W

Well No. #3 Luders "B"

Company Skelly Oil

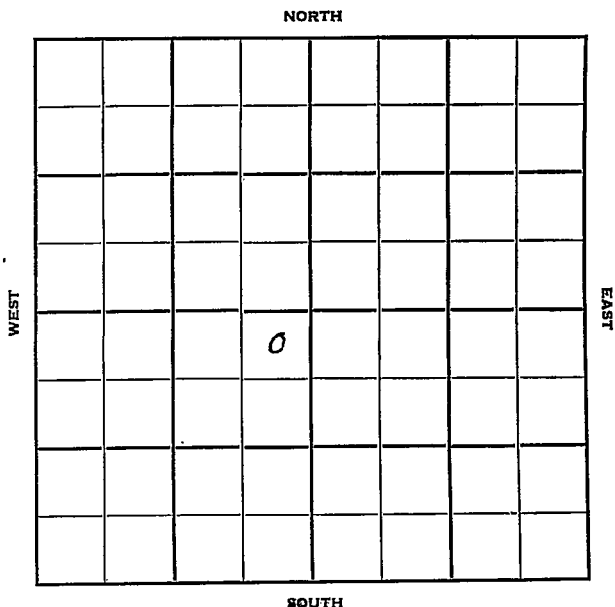

Sec. 7 Twp. 27 R. 12W ✓

Well No. #3 Luders "B" Farm

Skelly Oil Company

Hulme Drlg. - Contr. Contractor

Iuka Pool


330' Ft. from N. Line

 Ft. from S. Line

330' Ft. from E. Line

 Ft. from W. Line

NE NE SW

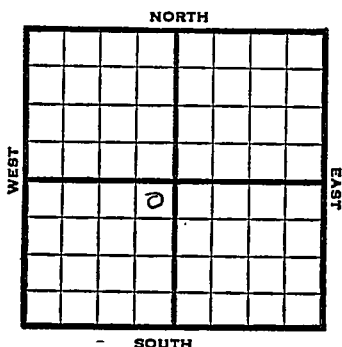

1950-

Elev 1866' REPORT

11/8

Location

1951

1/10

Spud 11-8-50

8" @ 393

Lans 3695

Miss 4077

Kinderhook 4114

Viola 4124

Simp 4205

Simp dol 4215

good por 4235-65

simp sand 4217

5" @ 4219

TD 4284

120 qt/4246-84

Hydrafrac 4219-84

S/56 bopd

S/31 bo

Comp 31 bopd

Completed

COMPLETED

County Pratt State Kansas
 Sec. 7 (Blk.) 27 (Sur.) 12W Map No. _____
 Operator Skelly Oil
 Well No. 3 Farm Luders "B"
 Elev. _____ Location NE NE SW

FIRST REPORT


0

330 Ft. From N Line SW
330 Ft. From E Line Quarter
 Ist. Report NUV 8 1950
 Completion _____
 Remarks _____
Hulme Drlg. - Contr.
 Spudding Date _____

Drlg. Data Iuka Pool
Location

J. E. TYRA

County Pratt State Kansas
 Sec. 7 (Blk. 27) (Sur. 12W) (Twp. Map No.)
 Operator Skelly Oil
 Well No. 3 Farm Luders "B"
 Elev. 1866 Location NE NE SW

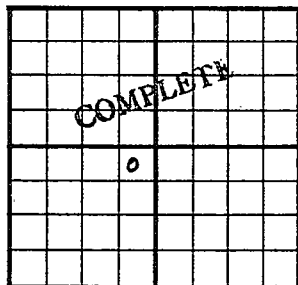

330 Ft. From N Line SW
330 Ft. From E Line Quarter
 1st. Report
 Completion JAN 1 0 1951
 Remarks Iuka Pool
Hulme Drlg. - Contr.
 Spudding Date 11-8-50

Drlg. Data Oil well TD 4284

8" @ 393 Lans. 3695 Miss. 4077

Kinderhook 4114 Viola 4124 Simp. 4205

Simp. dol. 4215 good por. 4235-65

Simp. sand 4217 5" @ 4219 TD 4284

120 qt/ 4246-84 Hydrofrac 4219-84

S/ 56 bopd S/ 31 bo Comp. 31 bopd

J. E. TYRA