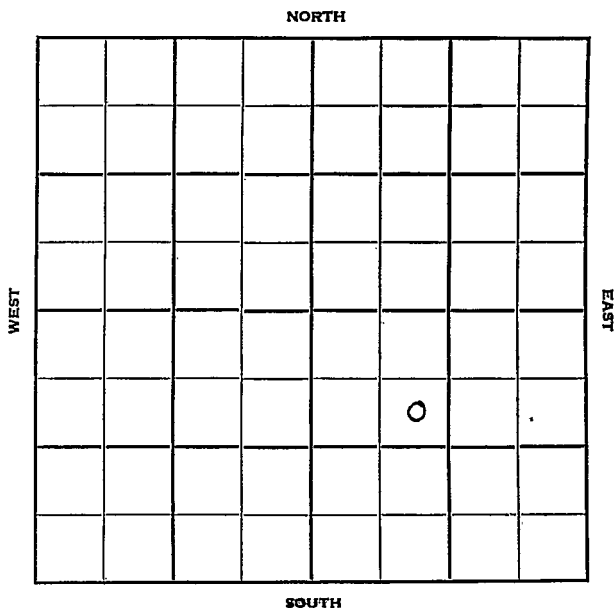


Section 7 Township 27 Range 12 WWell No. # 4 WagnerCompany Skelly Oil

Pratt

KANSAS

Sec. 7 Twp. 27 R. 12 W ✓

Well No. # 4 Wagner Farm

Skelly Oil Company

Contractor

Iuka Pool


990 Ft. from N. Line

Ft. from S. Line

Ft. from E. Line

990 Ft. from W. Line

SE NW SE

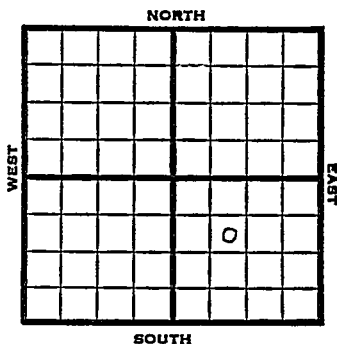

1951

Elev. 1876' REPORT

5/29

Location

8/1

Spud 6-6-51

Oil Well TD 4255

8" @ 411

Br Lime 3664 Lans. 3690

Miss 4112 Kh 4135

Viola 4160 Simp sh 4209

Dol. 4223 Sd 4230-55

4 $\frac{1}{2}$ " @ 4216 TD 4255 S/1 $\frac{1}{2}$  bo 15 hr


44 qt/4222-55 S/18 bopd Hydra

Comp. S/110 bopd

**COMPLETED**

J. E. TÝRA

County Pratt State Kansas  
 Sec. 7 (Blk. 27) (Sur. 12W) (Rge. Map No.)  
 Operator Skelly Oil  
 Well No. 4 Farm Wagner  
 Elev. 1876 Location SE NW SE

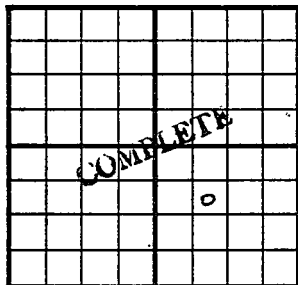

990 Ft. From N Line SE  
990 Ft. From W Line Quarter

Ist. Report

Completion AUG 1 1951

Remarks Tuka Pool

Spudding Date 6-6-51

Drlg. Data Oil well TD 4255

8" @ 411 Br. lime 3664 Lans. 3690

Miss. 4112 Kh. 4135 Viola 4160

Simp. sh. 4209 Dol. 4223 Sd. 4230-55

4½" @ 4216 TD 4255 S/ 1½ bo 15 hr.

44 qt/ 4222-55 S/ 18 bopd Hydrofrac

Comp. S/ 110 bopd

J. E. TYRA