


Pratt KANSAS

DX 78-1

Section 7 Township 27 Range 12W

Well No. 6 Wagner


Company Skelly Oil

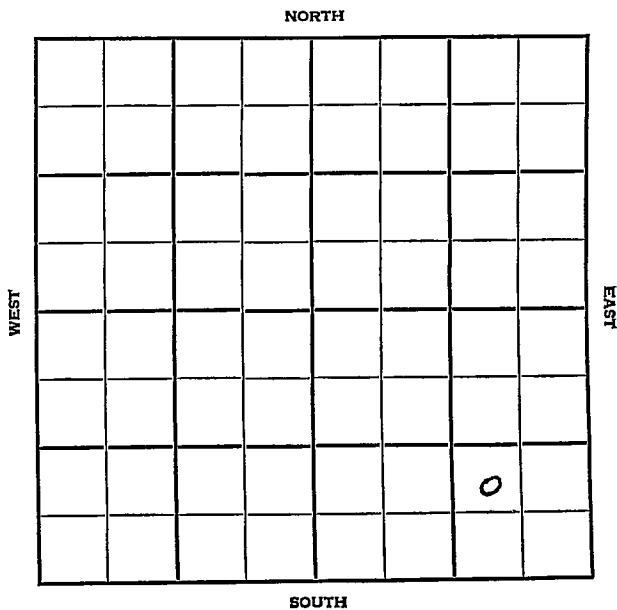

Pratt KANSAS

SEC.	TWP.	R.
7	27	12W
WELL NO.		
6 Wagner		
COMPANY		
Skelly Oil		
CONTRACTOR		
FARM		

_____ Ft. from N. Line
 990 _____ Ft. from S. Line
 1225 _____ Ft. from E. Line
 _____ Ft. from W. Line

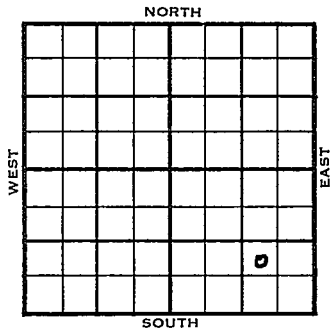

C W¹/₂ NW SE SE

	ELEVATION	REPORT
1954	1874'	
7/21	Location	
9/22	Spud 7-21-54	
	Oil Well	
	TD 4304'	
	8" @ 790'	
	Heeb 3496', Br. Lime 3668', Lans	
	3688', B KC 4032', Miss 4124', Viola	
	4178', Simp 4218', Simp dol. 4234'	
	Simp sd. 4248'	
	TD 4304'	
	5" @ 4303'	
	25/ 4277-81 80 gw 4 hr. 12/ 4271-75	
	10 gwph 24/ 4267-75 1 bo 18 bw	
	14 hr. 250 A CO to 4272'	
	24/ 4267-71 sd-oil-frac. S/ 2 gwph	
	PB 4265'	
	48/ 4256-64 sd-oil-frac. S/ 1 bw	
	16 hr.	
	DP to 4271'	
	18/ 4264-67 sd-oil-frac. CO to 4300	
	48/ 4284-90 S/ 3 bo 12 bw 4 hr.	
	200 A S/ 36 bo 85 bw 17 hr.	
	Comp 93 bopd. 128 bw.	

COMPLETED

