

Section 7 Township 27 Range 12W

Well No. #2 Lutheran Church

Company Jackson-Lindsley

NORTH

							0

WEST

EAST

SOUTH

Sec. 7 Twp. 27 R. 12-W ✓

Well No. #2 Lutheran Church Farm

Jackson - Lindsley Company

Jackson Drlg Contractor

Tuka


_____ Ft. from N. Line

175 Ft. from S. Line

330 Ft. from E. Line

_____ Ft. from W. Line

SE SE NE

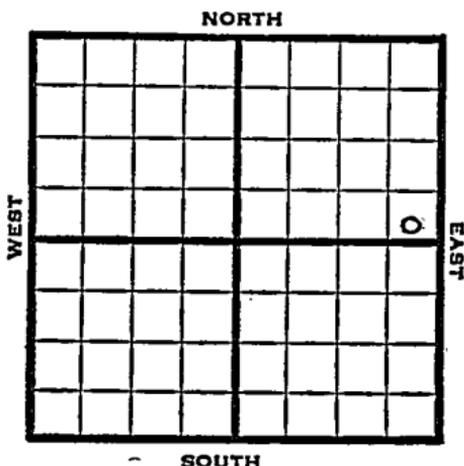

1950 Elev 1882' REPORT

12/13 Spud 12-8-50
8" @ 400
Drlg 1972'

1951
1/24

Spud 12-8-50
8" @ 400
Br lime 3690
Miss 4142
Viola 4188
Sand 4242-60
5" @ 4254
TD 4278
5 goph DD 4281
53 qt/4254-84
FU 1800' oil
S/6 boph Comp 150 bopd
Completed TD 4281'

Lans 3703
Kinderhook 4160
Simp sh 4238

COMPLETED

