


Section 7 Township 27 Range 12W

Well No. 1 Wagner

Company Skelly

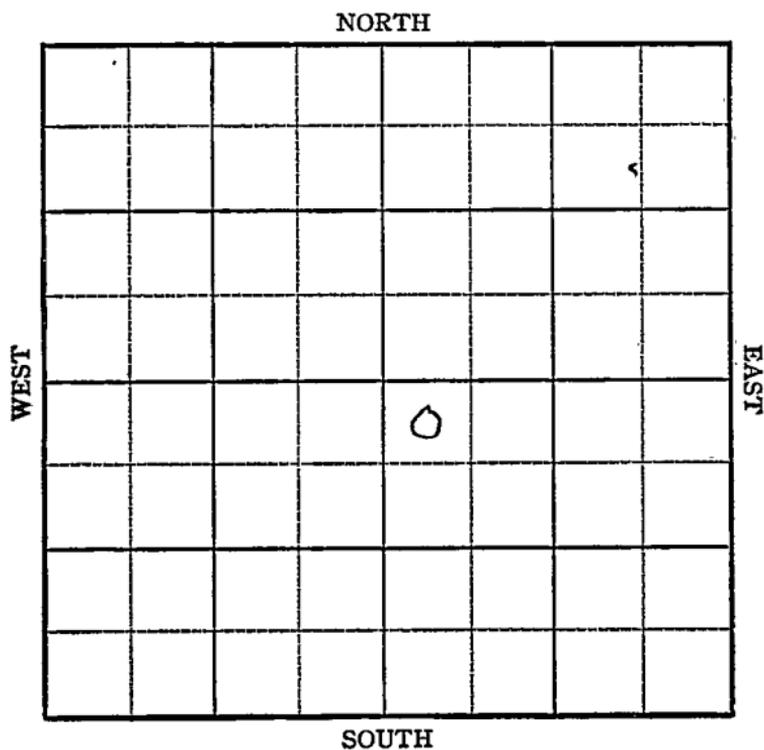

Sec. 7 Twp. 27 R. 12-W

Well No. #1 Wagner Farm

Skelly Company


Carmi Pool

330 Ft. from N. Line

_____ Ft. from S. Line

_____ Ft. from E. Line

330 Ft. from W. Line

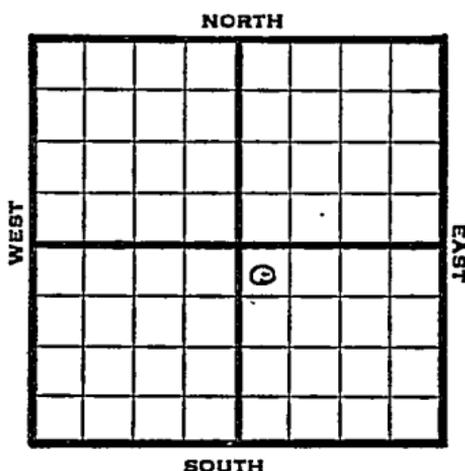

REPORT	
1948	Fl: 1966'
8/11	Loc
8/18	"
8/25	8" @ 452' 1185'
9/1	Drig. 3110'
9/8	Lansing 3693' Drig. 4155'
9/14	Miss. 4156' Simpson shale 4198' TD 4245' 5" @ 4216'
9/21	1000 acid swb 65 bbls oil & 12 W - 24 hrs.
9/29	40 qts 4229-45 Swb 9 bbls oil 24 hrs.
10/6	"
10/13	Pump 215 bbls oil - 21 hrs
10/19	"
10/26	"
11/3	"
11/10	"
11/16	"
11/23	TD 4245' Simp 4198' 5" @ 4216' 40 qts 4229-45 1000 acid Pump 86 Oil Pot 430 Gr. Comp
COMPLETED	

Pratt

County

Kansas

State

Map No. _____ Sec. 7 Twp. 27 R. 12W

Well No. 1 Wagner

Skelly


Company

FIRST REPORT

Contractor

NW SE

SECTION PLAT

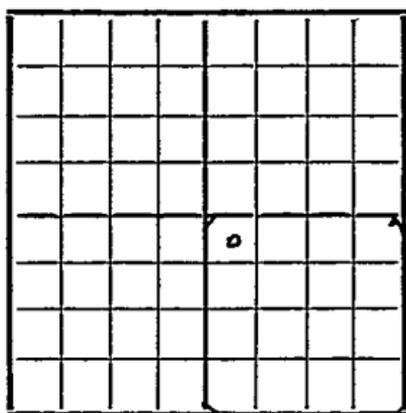

330 Ft. from N. Line

_____ Ft. from S. Line

_____ Ft. from E. Line

330 Ft. from W. Line

Carmi Pool

Remarks:

Location

Date
AUG 11 1948

Scout S. J. LEWIS

Map No. 54 Sec. 7 Twp. 27 R. 12W

Well No. 1 Wagner

Skelly Company

COMPLETE

Contractor

NW SE

E. 1866

SECTION PLAT

330 Ft. from N. Line

_____ Ft. from S. Line

_____ Ft. from E. Line

330 Ft. from W. Line

		0	

Pratt County

Location _____

Rig up _____

Drilling and Remarks:

Sun 4198.
5" @ 4216
409 to 4229 - 45'
16000 cu ft
Pump 16 oil BT
432 cu

RECORD

Cased _____ in., _____ ft.

Sand _____

Gas _____

Oil

Total Depth 4245

PRODUCTION

1st 24 hrs. Nat. _____

1st 24 hrs. after shot _____

Gas _____ Cu. Ft.

Dry Hole _____

Abandoned _____

Date

NOV 23 1948

19

S. J. LEWIS Scout