

# KANSAS


FORM 51 5M 10-41 PETROL

Pratt

Section 7 Township 27 Range 12-W

Well No. #1 Wagner

Company Darby

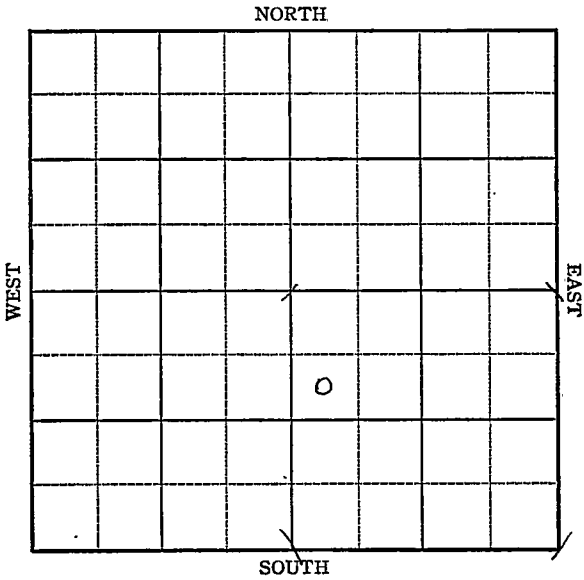

**KANSAS**

Pratt

Sec. 7 Twp. 27 R. 12-W

Well No. #1 Wagner Farm

Barby Company

Iuka


990 Ft. from N. Line

\_\_\_\_\_ Ft. from S. Line

\_\_\_\_\_ Ft. from E. Line

330 Ft. from W. Line

SW NW SE Elev. 1865

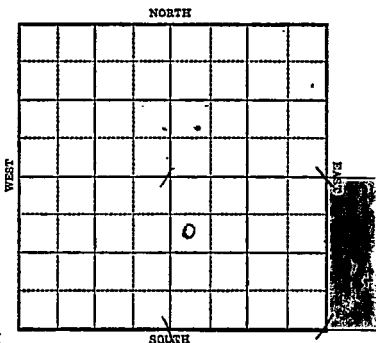

1943

R E P O R T

- 2/3 Derrick
- 2/10 Rotary
- 2/17 10" @ 493'  
Drlg. 1900'
- 2/24 Topeka 3117  
Drlg. 3170'
- 3/3 Lans 3689  
BKC 3970  
Miss. 4122  
Kind 4144  
Viola 4164  
Simp. sd. 4218  
T.D. 4227 $\frac{1}{2}$ '  
Set 5" @ ~~4226 $\frac{1}{2}$ '~~ RUST

Running 43' lower on Viola than Skelly Oil Co.  
#3 Beck "A" SW SE NW of 7-27-12W  
(Bomb Potential 2515 bbls)

- 3/10 5" @ 4222' corrected.  
SSO 4237-40  
Drlg. 4261'
- 3/17 Arb. 4321  
T.D. 4354 SW. PB
- 3/24 44 shots 4214-26 No shows.  
60' oil 12 hrs. 4237-50  
20 qts. 4237-44 C.O.

**OVER**

1943

3/31 600' oil in 17 $\frac{1}{2}$  hrs no water  
20 qts 4235-44-500' oil in hole.

4/7 Pump 5 oil per day

4/14 Arb. 4321  
T.D. 4354'

Only make 5 bbl oil a day.

**ABANDONED**

**KANSAS**  
 Map No. 54 Sec. 7 Twp. 27 R. 12W

Well No. 1 Wagner

Darby Company

**FIRST REPORT** Contractor

SW NW SE

990 Ft. from N. Line

\_\_\_\_\_ Ft. from S. Line

\_\_\_\_\_ Ft. from E. Line

330 Ft. from W. Line

SECTION PLAT


IUKA POOL *close*

Location \_\_\_\_\_

Rig up \_\_\_\_\_

Drilling and Remarks:

**Derrick**

RECORD

Cased \_\_\_\_\_ in., \_\_\_\_\_ ft.

Sand \_\_\_\_\_

Gas \_\_\_\_\_

Oil \_\_\_\_\_

Total Depth \_\_\_\_\_

PRODUCTION

1st 24 hrs. Nat. \_\_\_\_\_

1st 24 hrs. after shot \_\_\_\_\_

Gas \_\_\_\_\_ Cu. Ft.

Dry Hole \_\_\_\_\_

Abandoned \_\_\_\_\_

Date .

**FEB 3** 1943 19 \_\_\_\_\_

**S. J. LEWIS** Scout

Misc Small Maps *One*  
Cards *Best*  
Tracing *MB*  
France Map *✓*  
Scarborough Map *✓*  
Moody Map *✓*  
Geological Dept.  
Moody Flat Book

KANSAS  
 Map No. 54 Sec. 7 Twp. 27 R. 12W

Well No. 1 Wagner

Darby Company

ABANDONED Contractor

SW NW SE

SECTION PLAT

990 Ft. from N. Line

\_\_\_\_\_ Ft. from S. Line

\_\_\_\_\_ Ft. from E. Line

330 Ft. from W. Line

			1
		o	

IUKA POOL

Location \_\_\_\_\_

Rig up \_\_\_\_\_

Drilling and Remarks:

*Core 4321  
 only make soil  
 today. abandoned*

RECORD

Cased \_\_\_\_\_ in., \_\_\_\_\_ ft.

Sand \_\_\_\_\_

Gas \_\_\_\_\_

Oil \_\_\_\_\_

Total Depth 4.954

PRODUCTION

1st 24 hrs. Nat. \_\_\_\_\_

1st 24 hrs. after shot \_\_\_\_\_

Gas \_\_\_\_\_ Cu. Ft.

Dry Hole \_\_\_\_\_

Abandoned \_\_\_\_\_

Date

APR 14 1943 19

S. J. LEWIS Scout

Misc Small Maps *One*  
Cards *Book*  
Tracing *MS*  
France Map *MS*  
Scarborough Map *MS*  
Moody Map .....  
Geological Dept. ....  
Moody Flat Book .....