KANSAS


FORM 51 25M 3-49 PETROL

Pratt

Section 7 Township 27 Range 12-W

Well No. #3 Wagner

Company Skelly Oil

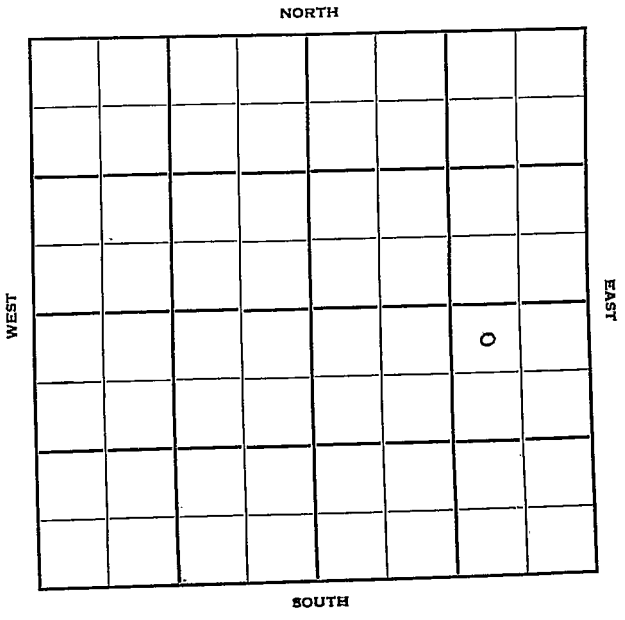

FORM 252-B
10M 9-49 PETROL

Pratt KANSAS

Sec. 7 Twp. 27 R. 12W

Well No. #3 Wagner Farm

Skelly Oil Company

Hulme Drlg. Contractor

Iuka Pool


330' Ft. from N. Line

Ft. from S. Line

990' Ft. from E. Line

Ft. from W. Line

NW NE SE

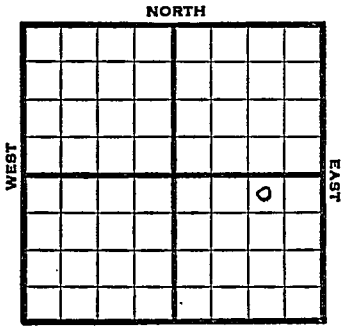

Oil Well

1950	Elev 1882 REPORT	
9/6	Drlg.	
10/11	Spud 9-4-50	
	8" @ 438	
	Heeb 3445	Doug 3535
	Lans 3705	Miss 4113
	Kinderhook 4136	Viola 4161
	Simp sh 4213	Simp sd 4220
	TD 4271	
	5" @ 4222	
	F/135 bo 9 hr	
	F/280 bo 24 hr	
	F/227 BO 15 hr	
	Completed	
	COMPLETED	

FORM 275 FOR SALE BY KANSAS BLUE PRINT CO.


County Pratt State Kansas

Sec. 7 (Blk. Twp.) 27 (Sur. Rge.) 12W Map No.

Operator Skelly Oil

Well No. 3 Farm Wagner

Elev. Location NW NE SE

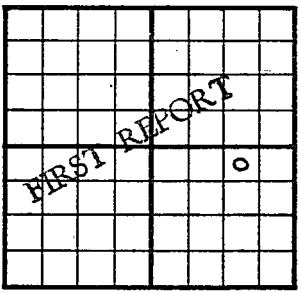

330 Ft. From N Line SE

990 Ft. From E Line Quarter

1st. Report SEP 6 1950

Completion

Remarks

Spudding Date

Drlg. Data Tuka Pool

drlg.

J. E. TYRA

SEP 8 1959

Scout Cards .....
Land Small Map .....
Land Wall Map .....
Tracings .....
France Map .....
Pierce Map .....
Misc. .....

Drlg. Data

FORM 275 FOR SALE BY KANSAS BLUE PRINT CO.


County Pratt State Kansas

Sec. 7 (Blk. Twp.) 27 (Sur. Rge.) 12W Map No.

Operator Skelly Oil

Well No. 3 Farm Wagner

Elev. 1882 Location NW NE SE

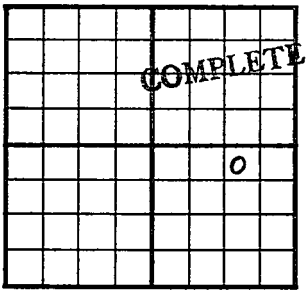

330 Ft. From N Line SE

990 Ft. From E Line Quarter

1st. Report

Completion OCT 11 1950

Remarks Iuka Pool

Hulme Drlg. - Contr.

Spudding Date 9-4-50

Drlg. Data Oil well TD 4271

8" @ 438 Heeb. 3445 Doug. 3535

Lans. 3705 Miss. 4113 Kinderhook 4136

Viola 4161 Simp. sh. 4213 Simp. sd. 4220

TD 4271 5" @ 4222 F/ 135 bo 9 hr.

F/ 280 bo 24 hr. F/ 227 bo 15 hr.

Comp.

J. E. TYRA

OCT 17 1950

Scout Cards	+ 3
Land Small Map	
Land Wall Map	3
Tracings	
France Map	
Pierce Map	
Misc.	

Drlg. Data