

Pratt

KANSAS



Sec. 7 Twp. 27 R. 12W

Well No. #5 Wagner Farm

Skelly Oil Company

Contractor


Ft. from N. Line

330 Ft. from S. Line

Ft. from E. Line

990 Ft. from W. Line

SE SW SE

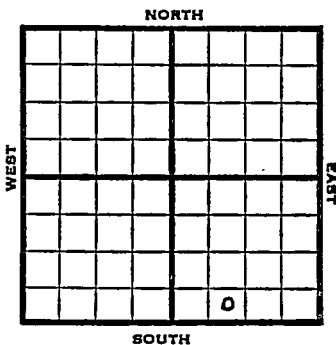

1952 Elev. 1866! REPORT

11/19 Location

11/27 "

12/4 "

12/11 Location

12/18 Drlg. 1780

12/25 " "

1/1 Lans 3677 Miss 4133 V 4163 Simp 4208
Drlg. 4231 RTD 4286 5" @ 4285

1/8 RTD 4286 5" @ 4285

1/22 NR

1/28 Spud 12-7-52 Oil-well TD 4286'
8" @ 466 Lans. 3677 Miss 4113
Viola 4163' Simp. 4208'
TD 4286' 5" @ 4285 Perf 135/4248-73
F/116 BO 2 hr. D-Hydro.
F/68 BO
Comp. BHB 3000 BOPD

COMPLETED

