


KANSAS

Sedgwick

Section 7 Township 27 Range 4W

Well No. #1 Ehlert *(Dehlert)*

Company W D Moorer et al

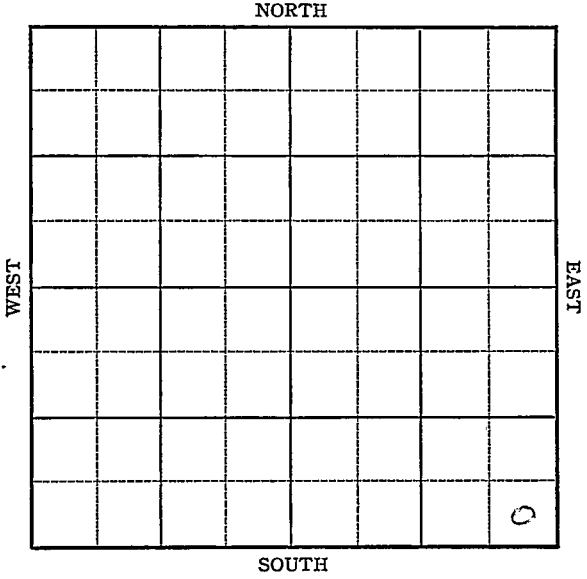

KANSAS

Sadgwick County


Sec. 7 Twp. 27 R. 4W

Well No. #1 Ehlert Farm

W. D. Moorer et al Company

Wildcat

NORTH

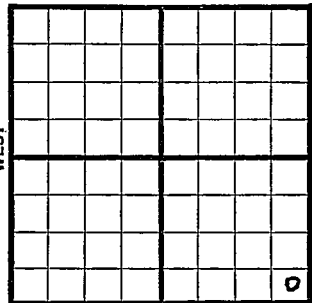

_____ Ft. from N. Line

330 Ft. from S. Line

350 Ft. from E. Line

_____ Ft. from W. Line

Elev. 1369

SOUTH

SE/C

1944

REPORT

- 7/19 Loc.
- 7/26 Drk.
- 8/2 10" @ 219 WOC
- 8/9 Drlg. 2375
- 8/16 Lans 2801
- Drlg. 3365
- 8/23 Miss. 3600
- Kind 3881
- Viola 4019
- Drlg. 4074
- 8/30 Simp 4040
- Arb ~~4138~~ 4138
- TD 4190

ABANDONED

