


KANSAS

Section 16 Township 27 Range 8W

Well No. #1 Sutton "B"

Company Bridgeport

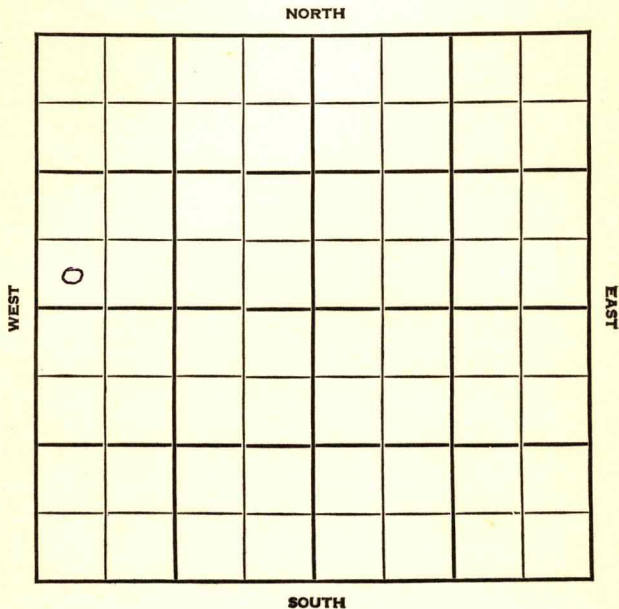

KANSAS

Kingman

Sec. 16 Twp. 27 R. 8W

Well No. #1 Sutton "B" Farm

Bridgeport Company

Wildcat


Ft. from N. Line

330' Ft. from S. Line

Ft. from E. Line

330' Ft. from W. Line

SW NW

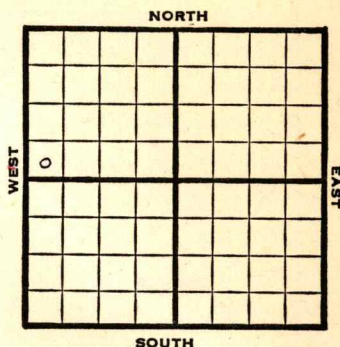

1948

Elev. 1667' REPORT

2/25 Location

3/3 "

3/10 "

3/17 RUR

3/24 8" @ 246'

Drlg. 1776'

3/31 **Lansing 3379'**

Drlg. 745'

4/7 **Miss. 4011'**

Viola 4318'

Simp Sd 4385'

Arb. 4489'

TD 4541'

ABANDONED

$$\begin{array}{r} 3379 \\ 1667 \\ \hline 1712 \end{array}$$

$$\begin{array}{r} 4011 \\ 1667 \\ \hline 2344 \end{array}$$

$$\begin{array}{r} 4385 \\ 1667 \\ \hline 2718 \end{array}$$

$$\begin{array}{r} 4489 \\ 1667 \\ \hline 2822 \end{array}$$

Map No. 36 Sec. 16 Twp. 27 R. 8WWell No. 1 Sutton "B"Bridgeport

Company

ABANDONED

Contractor

SW NW

E. 1667
SECTION PLAT

 Ft. from N. Line330 Ft. from S. Line Ft. from E. Line330 Ft. from W. LineKingman CountyLocation Rig up

Drilling and Remarks:

Miss 4011
Vista 4318.
Imp Sol 4385
Gr 4489

RECORD

Cased in., ft.Sand Gas Oil Total Depth 4541

PRODUCTION

1st 24 hrs. Nat. 1st 24 hrs. after shot Gas Cu. Ft.Dry Hole Abandoned

Date

APR 7 1948 19S. J. LEWIS Scout

Kansas

Map No. _____ Sec. 16 Twp. 27 R. 8WWell No. 1 Sutton "B"


_____ Bridgeport _____ Company

FIRST REPORT

_____ Contractor

SW NW

SECTION PLAT

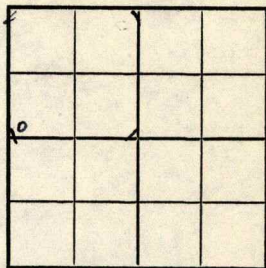

_____ Ft. from N. Line

330 Ft. from S. Line

_____ Ft. from E. Line

330 Ft. from W. LineKingman CountyLocation x

Rig up _____

Drilling and Remarks:

RECORD

Cased _____ in., _____ ft.

Sand _____

Gas _____

Oil _____

Total Depth _____

PRODUCTION

1st 24 hrs. Nat. _____

1st 24 hrs. after shot _____

Gas _____ Cu. Ft.

Dry Hole _____

Abandoned _____

Date

FEB 25 194819S. J. LEWIS Scout