


KANSAS

Kingman county

Section 35 Township 27 Range 8-W

Well No. #1, Woolleridge

Company A. G. Hill

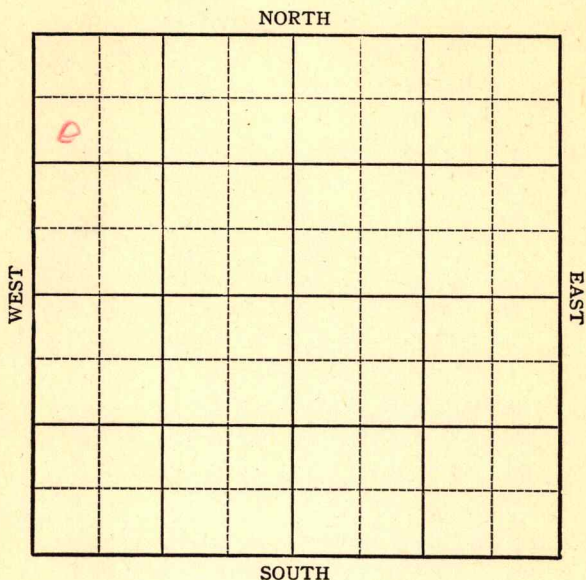

KANSAS

Kingman ✓

Sec. 35 Twp. 27 R. 8W

Well No. #1 Wooleridge Farm

A. G. Hill Company

Wildcat


990 Ft. from N. Line

Ft. from S. Line

Ft. from E. Line

330 Ft. from W. Line

SW NW NW

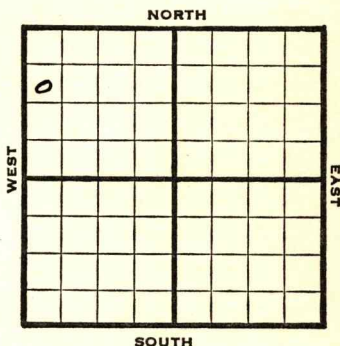

1946

Elev. 1599'

REPORT

10/23 Location  
10/29 "  
11/6 Derrick  
11/12 "  
11/20 285 Run 8"  
11/27 10" @ 285'  
Drlg 1835'  
12/3 Drlg 3210'  
12/10 Drlg 4072'  
12/17 Drlg 4530'

1947

1/2  
Lans 3312'  
Miss 4015'  
Kind 4144'  
Viola 4327'  
Simp 4371'  
Arb 4466'  
TD 4531'

ABANDONED

Kansas


Map No. 36 Sec. 35 Twp. 27 R. 8WWell No. 1 WooleridgeA. G. Hill Company

## FIRST REPORT

Contractor

SW NW NW

## SECTION PLAT

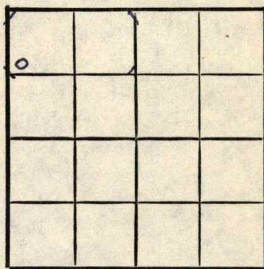990 Ft. from N. Line       Ft. from S. Line       Ft. from E. Line330 Ft. from W. LineKingman CountyLocation XRig up       

Drilling and Remarks:

## RECORD

Cased        in.,        ft.Sand       Gas       Oil       Total Depth       

## PRODUCTION

1st 24 hrs. Nat.       1st 24 hrs. after shot       Gas        Cu. Ft.Dry Hole       Abandoned       

Date

OCT 23 1946

19

S. J. LEWIS

Scout

Map No. 36 Sec. 35 Twp. 27 R. 8WWell No. 1 WoolleridgeA. G. Hill Company

ABANDONED

Contractor

SW NW NW

E11589  
SECTION PLAT

|   |  |  |  |
|---|--|--|--|
|   |  |  |  |
| 0 |  |  |  |
|   |  |  |  |
|   |  |  |  |
|   |  |  |  |

990 Ft. from N. Line       Ft. from S. Line       Ft. from E. Line330 Ft. from W. LineKingman CountyLocation                                 Rig up                                 

Drilling and Remarks:

*Lane 3812*  
*Miss 4015*  
*Kind 4144*  
*Viola 4327*  
*Simp 4371*  
*Dr 44466*

## RECORD

Cased            in.,            ft.Sand                                 Gas                                 Oil                                 Total Depth 4531

## PRODUCTION

1st 24 hrs. Nat.                                 1st 24 hrs. after shot                                 Gas                                  Cu. Ft.Dry Hole                                 Abandoned                                 

Date

JAN 2 1947 19S. J. LEWIS Scout