

KANSAS Grant

Section 8 Township 27 Range 36W

Well No. 1 Petro-Tate

Company Magnolia

Hugoton NORTH

				0			

WEST

EAST

SOUTH

KANSAS

Grant

36-W

Sec. 8 Twp. 27 R.

Well No. #1 Petro-Tate Farm

Magnolia Company

Hugoton Pool


NORTH

330' Ft. from N. Line

Ft. from S. Line

Ft. from E. Line

330' Ft. from W. Line

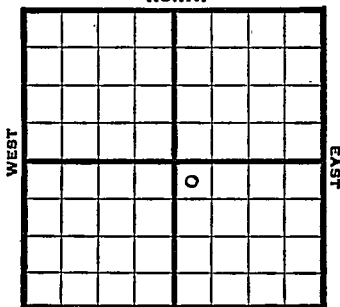

NW SE

1947

Elev. 3108' REPORT

11/12

Location

11/19

10" @ 740'

11/25

Drlg. 2721'

12/3

TD 2750'

7" @ 2730'

RUST

12/10

144 shots 2650-80' - 7000 acid

120 shots 2608-32' - 7000 acid

72 shots 2558-78' - 7000 acid.

72 shots 2514-22' - 6000 acid.

12/23

7" @ 2730'

Perf.

27000 acid

16,300,000 Gas

405# R. Pr.

TD 2750'

**COMPLETED**

Map No. \_\_\_\_\_ Sec. 8 Twp. 27 R. 36W

Well No. 1 Petro-Tate

Magnolia Company

FIRST REPORT Contractor

NW SE

SECTION PLAT

330 Ft. from N. Line

\_\_\_\_\_ Ft. from S. Line

\_\_\_\_\_ Ft. from E. Line

330 Ft. from W. Line


Grant County

Location X

Rig up \_\_\_\_\_

Drilling and Remarks:

RECORD

Cased \_\_\_\_\_ in., \_\_\_\_\_ ft.

Sand \_\_\_\_\_

Gas \_\_\_\_\_

Oil \_\_\_\_\_

Total Depth \_\_\_\_\_

PRODUCTION

1st 24 hrs. Nat. \_\_\_\_\_

1st 24 hrs. after shot \_\_\_\_\_

Gas \_\_\_\_\_ Cu. Ft.

Dry Hole \_\_\_\_\_

Abandoned \_\_\_\_\_

Date

NOV 12 1947 19

S. J. LEWIS Scout

Map No. \_\_\_\_\_ Sec. 8 Twp. 27 R. 36W

Well No. 1 Petro-Tate

Magnolia Company

**COMPLETE**

Contractor

NW SE

*E. J. 3108*

**SECTION PLAT**

330 Ft. from N. Line

\_\_\_\_\_ Ft. from S. Line

\_\_\_\_\_ Ft. from E. Line

330 Ft. from W. Line

		6	

Grant County

Location \_\_\_\_\_

Rig up \_\_\_\_\_

Drilling and Remarks:

*7" @ 2730*

*Perf*

*27000 acid*

*16,300,000 Gas*

*405 # R. B.*

**RECORD**

Cased \_\_\_\_\_ in., \_\_\_\_\_ ft.

Sand \_\_\_\_\_

Gas \_\_\_\_\_

Oil \_\_\_\_\_

Total Depth 2730

**PRODUCTION**

1st 24 hrs. Nat. \_\_\_\_\_

1st 24 hrs. after shot \_\_\_\_\_

Gas \_\_\_\_\_ Cu. Ft.

Dry Hole \_\_\_\_\_

Abandoned \_\_\_\_\_

Date

DEC 23 1947 19

S. J. LEWIS Scout