
FORM 51 25M 8-50 WESTERN Kingman KANSAS

Section 30 Township 27 Range 9 W

Well No. # 1 Sheldon

Company C R A

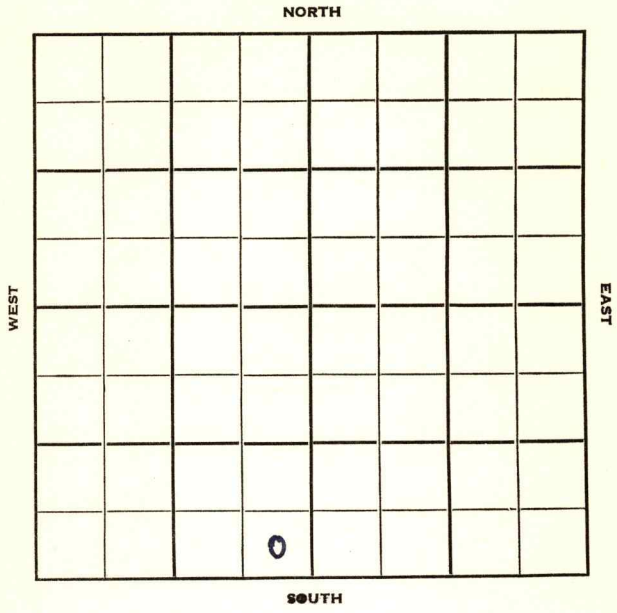

FORM 252-B
10M 8-51 TPCO.

Kingman KANSAS

Sec. 30 Twp. 27 R. 9W

Well No. #1 Sheldon Farm

C.R.A. Company

CRA - Contr. Contractor

Wildcat


Ft. from N. Line

330' Ft. from S. Line

330' Ft. from E. Line

Ft. from W. Line

SE SE SW

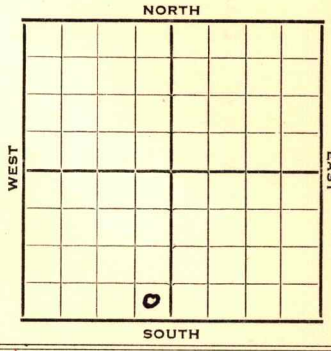

1952	Elev. 1660' REPORT
6/18	Location
6/25	"
7/2	"
7/9	"
7/17	8" @ 277 Drlg. 1785'
7/23	Br Li 3423 Lans. 3437 Drlg. 3615'
7/30	Miss Chert 3980 DST 3980-92, 3/4 hr. 30' GCM 0# KH 4078 V 4283 DST 4283-89, 1/2 hr. 1440' gas 50' HO&GCM 40' wtr. 1230# DST 4281-94, 1 hr. 1440' gas 165' ? O&FCM 45' wtr. 1230# Drlg. 4330'
8/6	Simp Shale 4353 Simp sd 4361 Arb. 4451-86 RTD 5" @ 4404
8/13	CO 4384 48/4362-74 200' wtr. PB 4319 72/4283-87½ B/½ galo & 46 galwph 22/4287½-92 B/ 2 galo & 50 galwph 36/4292-98 PB 4283'
8/20	6/4281-82½ NS CO 4286 6/4282½-84 2 qts wtr. 6/4284-85½ 1 galw CO 4288 6/4285½-87 5 galwph 500 A S/5 BWPH & trace shut down

OVER

1952

8/27 Spud 7-10-52
D&A TD 4486 8" @ 277'
Br Li 3423 Lans. 3437
Miss. 3980
DST 3980-92, open 3/4 hr. rec. 30' gcm 0# Kh. 4078 Viola 4283
DST 4283-89 open ½ hr. rec. 1440' gas 50' ho & gcm 40' wtr 1230#
DST 4281-94 open 1 hr. rec. 1440' gas 165' ho & gcm 45' wtr. 1230#
Simp. sh. 4353 Simp sd 4361
Arb. 4451
5" @ 4404 TD 4486 CO to 4384
48/ 4362-74 FU 200' wtr. 15 min.
PB 4319 27/ 4283-87 B/ ½ go
46 gwph 27/ 4287-92 B/ 2 go
50 gwph 36/ 4292-98 PB 4283
6/ 4281-82 CO to 4286 6/ 4282-84
2 qt. wtr. 6/ 4284-85 1 gw
CO to 4288 6/ 4285-87 5 gwph
500 A S/ 5 gwph SP 4000
40/ 3980-90 B/ wtr. D&A

ABANDONED

FORM 275 FOR SALE BY KANSAS BLUE PRINT CO.


County Kingman State Kansas

Sec. 30 (Blk. Twp.) 27 (Sur. Rge.) 9W Map No.

Operator C. R. A.

Well No. 1 Farm Sheldon

Elev. Location SE SE SW

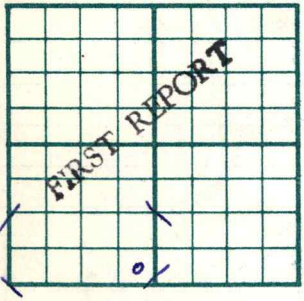

330 Ft. From S Line SW

330 Ft. From E Line Quarter

1st. Report JUN 1 8 1952

Completion

Remarks Magnolia - FO

CRA - Contr.

Spudding Date

Drlg. Data Wildcat

Location

J. G. McGEHEE

FORM 275 FOR SALE BY KANSAS BLUE PRINT CO.


County Kingman State Kansas

Sec. 30 (Blk. Twp.) 27 (Sur. Rge.) 9W Map No.

Operator C R A

Well No. 1 Farm Sheldon

Elev. 1660 Location SE SE SW

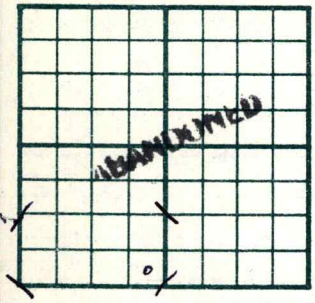

330 Ft. From S Line SW

330 Ft. From E Line Quarter

1st. Report

Completion AUG 27 1952

Remarks Wildcat

CRA - Contr.

Spudding Date 7-10-52

Drlg. Data D & A TD 4486

8" @ 277 Br. lime 3423 Lans. 3437

Miss. 3980 DST 3980-92 open 3/4 hr.

Rec. 30' gcm 0# Kn. 4078 Viola 4283

DST 4283-89 open ½ hr. Rec. 1440' gas

50' ho & gcm 40' wtr. 1230# DST 4281-

94 open 1 hr. Rec. 1440' gas 165' ho &

gcm 45' wtr. 1230# Simp. sh. 4353

Simp. sd. 4361 Arb. 4451 5" @ 4404

TD 4486 CO to 4384 48/ 4362-74

FU 200' water 15 min. PB 4319

27/ 4283-87 B/ ½ go 46 gwph 27/ 4287-92

B/ 2 go 50 gwph 36/ 4292-98 PB 4283

6/ 4281-82 CO to 4286 6/ 4282-84

2 qt. wtr. 6/ 4284-85 1 gw co to 4288

J. G. McGEHEE

Drlg. Data

6/ 4285-87 5 gwph 500 A S/ 5 bwph

SP 4000 40/ 3980-90 B/ water

