


DX 78-1 Kingman

**KANSAS**

Section 9 Township 27 Range 9W

Well No. 1 Valdois

Company CRA & Stearns

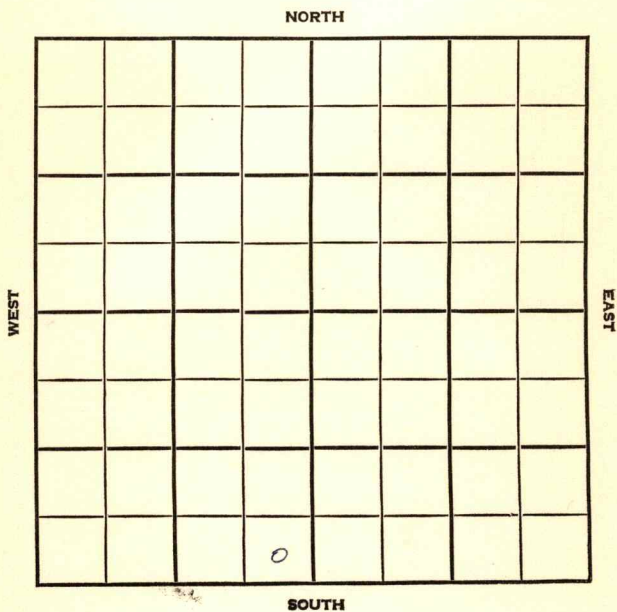

Kingman

KANSAS

SEC. 9	TWP. 27	R. 9W
-----------	------------	----------


WELL NO. #1 Valdois FARM

COMPANY CRA & Stearns

CONTRACTOR Stearns

WILDCAT

\_\_\_\_\_ FT. FROM N. LINE  
 \_\_\_\_\_ FT. FROM S. LINE  
 \_\_\_\_\_ FT. FROM E. LINE  
 \_\_\_\_\_ FT. FROM W. LINE

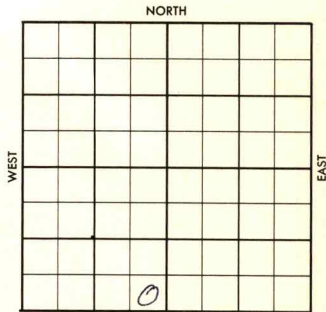

SE SE SW

Mag., - FO; Stanolind <sup>SOUTH</sup> - AC  
 Herndon - DHM;

1956	ELEVATION 1721'	REPORT
------	--------------------	--------

8-8 Comm. 8-3-56  
 8" @ 355 w/285  
 Drlg. 1621'

8-29 DST 3980-89 op 90 min. rec. 30' mud,  
 BHP 240/20".  
 DST 3989-4004 op 45 min. rec. 12' mud,  
 BHP 0/20".  
 DST 4240-46 op 1 hr., rec. 45' WCM,  
 BHP 1300/20".  
 D & A  
 H. 3229'; Dg. 3249'; BL. 3432'; L. 3445'  
 M. 3981'; V. 4243'; S. 4321'; ##  
 S. sd. 4328'; A. 4416';  
 TD 4440'

ABANDONED

County Kingman Elev. \_\_\_\_\_  
 Sec. 9 Twp. 27 Rge. 9W  
 Company CRA & Stearns  
 Farm Name Valdois No. 1

TOPS	DEPTH	LOG	DATUM	Loc. in Sec.
Anh.				SE SE SW
Tp.				
H.				
Tr.				
Dg.				
BL.				
L.				Geol. _____
K.C.				Contr. _____
B.K.C.				<u>Stearns</u>
Ce.				Pool _____
C.				<u>Wildcat</u>
M.				
M.				
K.				
Mz.				
Mo.				
V.				
S.				
S.				
A.				
R.				
PE.				
G.				
T.D.				

FIRST REPORT  
 AUG 8 1956

Date Comm. 8-3-56 Mag. FO, Herndon DIM,  
 Stanolind AC  
 8" @ 355/225 drlg. 1621

Aug 1 1956

LR

Co.  
Lse.  
No.  
Sec.  
T.  
R.

County Kingman Elev. 1721  
 Sec. 9 Twp. 27 Rgs. 9W  
 Company CRA & Stearns  
 Farm Name Valdois No. 1

TOPS	DEPTH	LOG	DATUM	Loc. in Sec.
Anh.				SE SE SW
Tr.				
H.	3229			
Tr.				
Dg.	3249			
Bl.	3432			
L.	3445			
K.C.				Geol.
B.K.C.				Contr.
Ce.				Stearns
C.				Pool
M.	3981			Wildcat
M.				
K.				
Mz.				
Mo.				
V.	4243			ABANDONED AUG 20 1958
S.	4321			
S. <i>sd</i>	4328			
A	4416			
R.				
Pe.				
G.				
TD	4440			

Date Comm. 8-3-56 Mag. FC, Herndon DIM, Stanolind AC  
 8" @ 355/225 drlg. 1621

AUG 15 '56  $\phi$  3580 AUG 22 '56 DST 3980-89  
 90" rec 30' Md BHP 240/20  
 DST 3989-4004 45" 12' Md  
 BHP 0/20" DST 4240-46 02/1m  
 45' WCM BHP 1300/20  $\phi$  4246  
 AUG 29 '56

DEA