

KANSAS

Grant

Section 9 Township 27 Range 38W

Well No. #1 Amden

Company Stanolind

Hugoton Pool

NORTH

WEST

EAST

				○			

SOUTH

KANSAS

Grant

Sec. 9 Twp. 27 R. 38WWell No. #1 Amden FarmStanolind Company

Hugoton Pool


Ft. from N. Line

150' Ft. from S. Line

Ft. from E. Line

150' Ft. from W. Line

SW NE

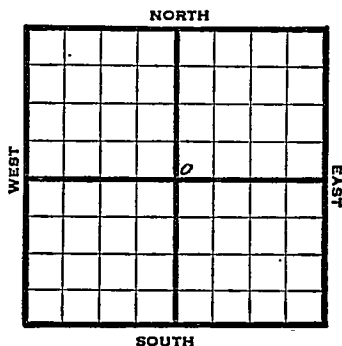

1948

Elev. 3172' REPORT

2/18 Location

2/25 "

3/3 "

3/10 "

3/17 "

3/24 "

3/31 10" @ 548'

Drlg. 2030'

4/7 TD 2400'

7" @ 2396'

RUST

4/14 "

4/21 Drlg. 2580'

4/28 7" @ 2396'

235 of 5" Perf liner @ 2606'

17,000 Acid

Gas 16,732,000 Gas

R, Pr. 435#

TD 2606'

COMPLETED

Map No. _____ Sec. 9 Twp. 27 R. 38W

Well No. 1 Amden

Stanolind Company

FIRST REPORT

Contractor _____

SW NE

SECTION PLAT

_____ Ft. from N. Line

150 Ft. from S. Line

_____ Ft. from E. Line

150 Ft. from W. Line

Grant County

Location X

Rig up _____

Drilling and Remarks:

RECORD

Cased _____ in., _____ ft.

Sand _____

Gas _____

Oil _____

Total Depth _____

PRODUCTION

1st 24 hrs. Nat. _____

1st 24 hrs. after shot _____

Gas _____ Cu. Ft.

Dry Hole _____

Abandoned _____

Date

FEB 18 1948 19 S. J. LEWIS Scout

Map No. _____ Sec. 9 Twp. 27 R. 39W

Well No. 1 Amden

Stanolind Company

COMPLETE

Contractor

E13172

SW NE

SECTION PLAT

		0	

_____ Ft. from N. Line

150 Ft. from S. Line

_____ Ft. from E. Line

150 Ft. from W. Line

Grant County

Location _____

Rig up _____

Drilling and Remarks:

7" C2386

235-240" Cylinders

C2606

17000 rods

16, 232, 000 Sec

420" R.P.

RECORD

Cased _____ in., _____ ft.

Sand _____

Gas _____

Oil _____

Total Depth 2606

PRODUCTION

1st 24 hrs. Nat. _____

1st 24 hrs. after shot _____

Gas _____ Cu. Ft.

Dry Hole _____

Abandoned _____

Date

APR 28 1948 19 S. J. LEWIS Scout