KANSAS


FORM 51 25M 8-50 WESTERN

Grant

Section 9 Township 27 Range 35W

Well No. #1 Meyer

Company Kansas-Nebraska

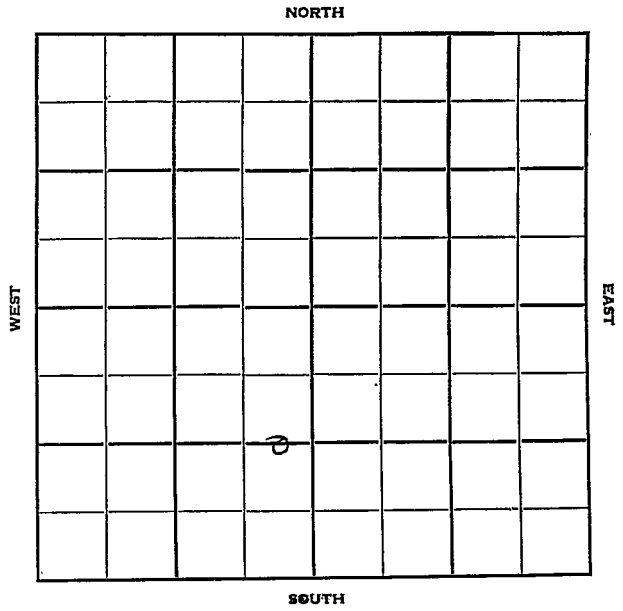

FORM 252-B
10M 11-50 PETROL

Grant KANSAS

Sec. 9 Twp. 27 R. 35 W

Well No. # 1 Meyer Farm

Kansas - Nebraska Company

Contractor

Hugoton Pool


Ft. from N. Line

1320 Ft. from S. Line

330 Ft. from E. Line

Ft. from W. Line

C E½ E½ SW

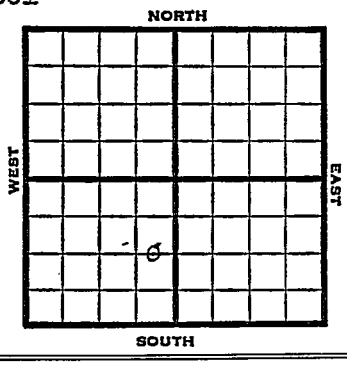

1951	Elev. 3049' REPORT
4/25	Spud 4-10-51 10" @ 819 Drlg. 2766'
7/18	Spud 4-10-51 Gas Well TD 2800 10" @ 819 7" @ 2792 TD 2800 60/2575-85 90/2591-2606 78/2635-48 120/2679-2709 174/2721-50 38000 A Her. 2575 Krider 2591 Win 2635 Ft. Riley 2679 Comp. 3,814,000 gas 408# COMPLETED

FORM 275 FOR SALE BY KANSAS BLUE PRINT CO.


County Grant State Kansas

Sec. 9 (Blk. Twp.) 27 (Sur. Rge.) 35W Map No.

Operator Kansas - Nebraska

Well No. 1 Farm Meyer

Elev. 3049. Location C E½ E½ SW

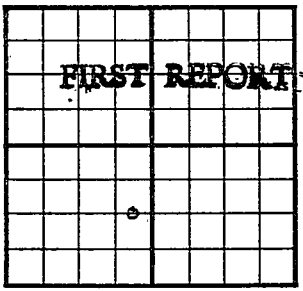

1320Ft. From S Line SW

330Ft. From E Line Quarter

1st. Report APR 25 1951

Completion

Remarks

Spudding Date 4-10-51

Drlg. Data Hugoton Pool

10" @ 819 drlg. 2766

J. E. TYRA

FORM 275 FOR SALE BY KANSAS BLUE PRINT CO.


County Grant State Kansas

Sec. 9 (Blk. Twp.) 27 (Sur. Rge.) 35W Map No.

Operator Kansas - Nebraska

Well No. 1 Farm Meyer

Elev. 3049 Location C E½ E½ SW

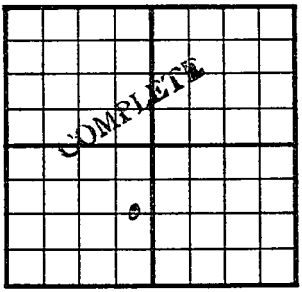

1320 Ft. From S Line SW

330 Ft. From E Line Quarter

1st. Report

Completion JUL 1 8 1951

Remarks Hugoton Pool

Spudding Date 4-10-51

Drlg. Data Gas well TD 2800

10" @ 819 7" @ 2792 TD 2800

60/ 2575-85 90/ 2591-2606 78/ 2635-48

120/ 2679-2709 174/ 2721-50 38000 A

Her. 2575 Krider 2591 Win. 2635

Ft. Riley 2679 Comp. 3,814,000 gas 408#

J. E. TYRA