


DX 78-1 Kingman

KANSAS

Section 9 Township 27 Range 7W

Well No. 1 R. Anderson

Company Heathman & Seeligson

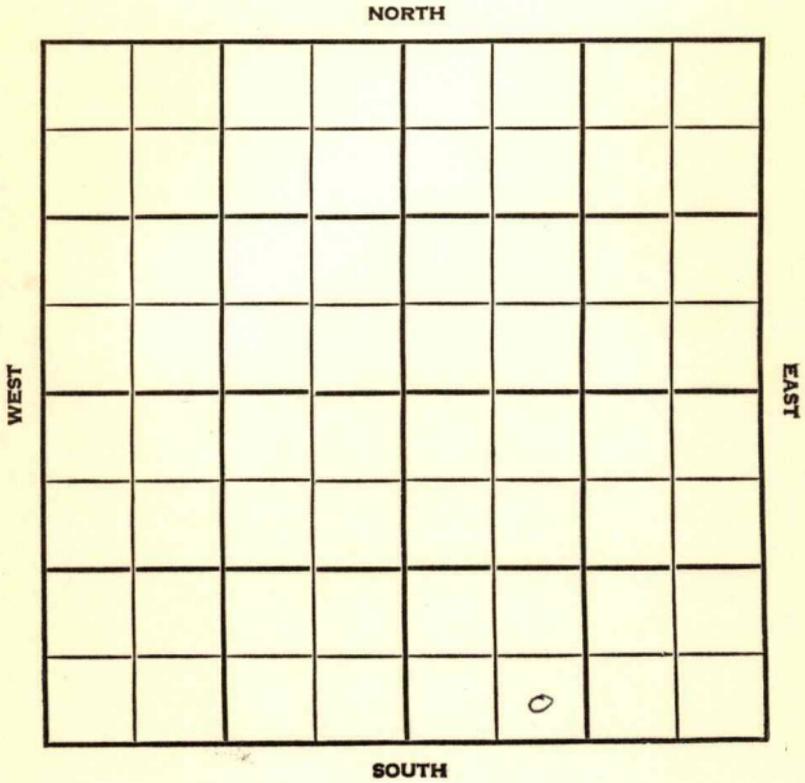

Kingman KANSAS


SEC.	TWP.	R.
9	27	7W

WELL NO. 1 R. Anderson FARM

COMPANY Heathman & Seeligson

CONTRACTOR Co. Tools  
Wooldridge Pool

\_\_\_\_\_ Ft. from N. Line  
330 \_\_\_\_\_ Ft. from S. Line  
\_\_\_\_\_ Ft. from E. Line  
990 \_\_\_\_\_ Ft. from W. Line

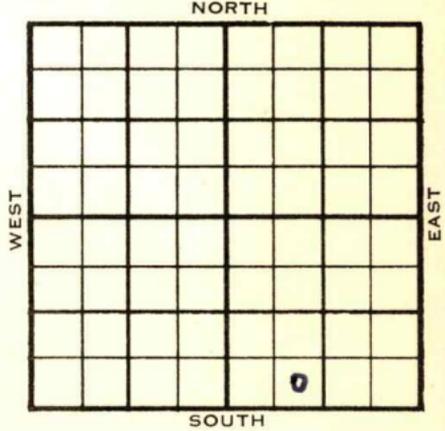

SE SW SE

	ELEVATION	REPORT
1955	1531'	

3/30 Spud 3-26-55  
8" @ 183'  
Drlg. 2180'

4/13 Spud 3-26-55 - D&A  
TD 4265'  
8" @ 183'  
Br line 3112', Lans. 3126', Cong. 3738', Miss. 3821'  
DST 3820-40', opn 2 hrs., gas in 14", 2,130,000 cfg, 30", 2,930,000 cfg, 2 hrs., rec. 110' gcm, 1450#  
DST 3840-55, opn 2 hrs., rec. 60' wcm, 1250#  
Kh. 3976', Viola 4121'  
DST 4124-27', opn 2 hrs., rec. 2040' sw, 1450#  
Simp. 4143'  
DST 4129-44, opn 2 hrs., rec. 3430' sw, 1450#  
DST 4139-44, opn 2 hrs., rec. 1145' sw, 1400#  
Arb. 4257'  
TD 4265'  
D&A

**ABANDONED**


County Kingman State Kansas

Sec. 9 (Blk. 27 (Sur. 7W Map No.           )  
 (Twp.) (Rge.)

Operator Heathman & Seeligson

Well No. 1 Farm R. Anderson

Elev.            Location SE SW SE

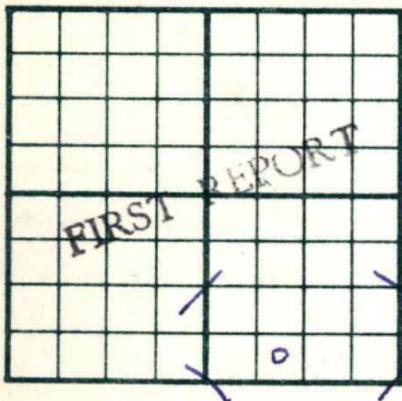

330 Ft. From S Line SE

990 Ft. From W Line Quarter

Ist. Report MAR 30 1955

Completion           

Remarks           

Co. tools

Spudding Date 3-26-55

Drlg. Data Wooldridge Pool

8" @ 183 drlg. 2180

FABEN GILSTRAP

County Kingman State Kansas

Sec. 9 (Blk. 27) (Sur. Rge.) 7W Map No.

Operator Heathman & Seeligson

Well No. 1 Farm R. Anderson

Elev. 1531 Location SE SW SE



330 Ft. From S Line SE

990 Ft. From W Line Quarter

Ist. Report

Completion APR 13 1955

Remarks Wooldridge Pool

Co. tools

Spudding Date 3-26-55

Drlg. Data D & A TD 4265

8" @ 183 Br. lime 3112 Lans. 3126

Cong. 3738 Miss. 3821 DST 3820-40

open 2 hr. gas in 14 min. 2,130,000 cfg

30 min. 2,930,000 cfg 2 hr. Rec. 110'

gcm 1450# DST 3840-55 open 2 hr.

Rec. 60' wcm 1250# Kh. 3976

Viola 4121 DST 4124-27 open 2 hr.

Rec. 2040' sw 1450# Simp. 4143

DST 4129-44 open 2 hr. Rec. 3430' sw

1450# DST 4139-44 open 2 hr. Rec.

1145' sw 1400# Arb. 4257 TD 4265

D & A

FABEN GILSTRAP