

DX 78-1

Kingman


KANSAS

Section 9 Township 27 Range 7 W

Well No. #1 Graber

Company Virginia Drlg.

NORTH

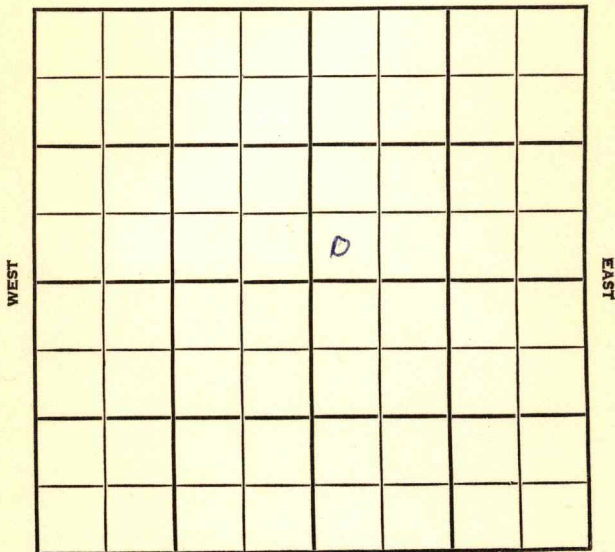

SOUTH

SEC. 9	TWP. 27	R. 7W
-----------	------------	----------

WELL NO. #1 Graber FARM

COMPANY Virginia Drlg.

CONTRACTOR Co. Tools


_____ Ft. from N. Line

_____ Ft. from S. Line

_____ Ft. from E. Line

_____ Ft. from W. Line

~~###~~ SW SW NE

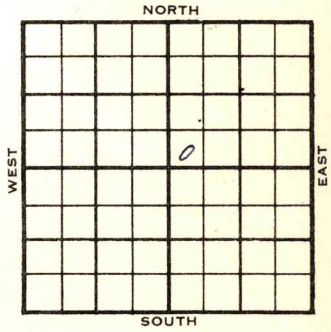

	ELEVATION	REPORT
1956	1538'	
2-29	RUR	
3-14	Comm. 2-28-56 8 5/8" @ 190/180 DST 3859-3909 op 1 hr. rec. 610' sw. D & A L. 3170 M. 3857 TD 3909'	

ABANDONED

County Kingman Elev. 1538
 Sec. 9 Twp. 27 Rge. 7W
 Company Virginia Drlg.
 Farm Name Graber No. 1

TOPS	DEPTH	LOG	DATUM
Anh.			
TP.			
H.			
Tr.			
Dg.			
Bl.			
L.	<u>3170</u>		<u>1637</u>
K.C.			
B.K.C.			
Ce.			
C.			
M.	<u>3857</u>		<u>2319</u>
M.			
K.			
Mz.			
Mq.			
V.			
S.			
S.			
A.			
R.			
PE.			
G.			
T.D.	<u>3909</u>		

Loc. in Sec. SW SW NE
 Geol. _____
 Contr. _____
 Co. tools _____
 Pool _____

ABANDONED

10

Date Comm. 2-28-56 MAR 14 1956
8 5/8" @ 190/180 DST 3859-3909
open 1 hr. rec. 610' sw

D & A

Co.
Lse.
No.
Sec.
T.
R.

County Kingman Elev. _____
 Sec. 9 Twp. 27 Rge. 7W
 Company Virginia Drlg.
 Farm Name Graber No. 1

TOPS	DEPTH	LOG	DATUM	Loc. in Sec.
Anh.				SW SW NE
Tr.				
H.				
Tr.				
Dg.				
B.L.				
L.				Geol. _____
K.C.				Contr. _____
B.K.C.				Co. tools
Ce.				Pool
C.				
M.				
M.				
K.				
Mz.				
Me.				
V.				
S.				
S.				
A.				
R.				
Pe.				
G.				
T.D.				

FEB 29 '56
 FIRST REPORT

Date Comm. RUR

~~27~~

Co.
Lse.
No.
Sec.
T.
R.