


Section 1 Township 28 Range 5WWell No. #1 SimonsCompany Cities Service

NORTH

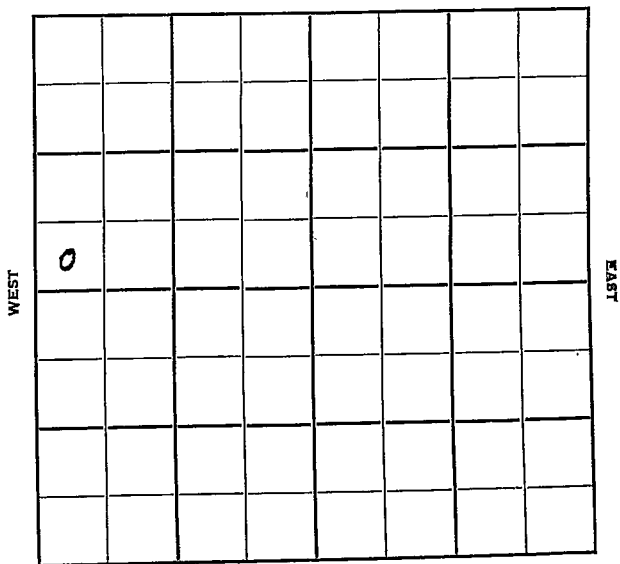

SOUTH

KANSAS

Kingman

Sec. 1 Twp. 28 R. 5-W

Well No. #1 Simons Farm ☒

Cities Service

Company

Barbour Drlg.

Contractor

Wildcat


 Ft. from N. Line

330 Ft. from S. Line

330 Ft. from E. Line

330 Ft. from W. Line


SW SW NW

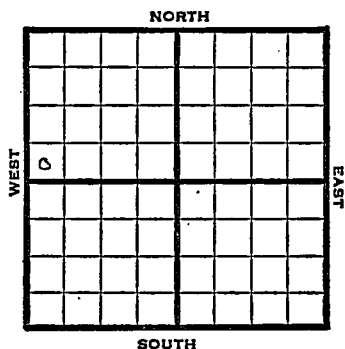

1950 Elev 1419 REPORT

8/30 Location
10/11 Spud 8-29-50
8" @ 209
Lans 2894 Miss chat 3736
Miss dol 3768-76
DST 3750-76 op 45 min rec 80' mud
DST 3768-88 opn 45 min rec 120' mud
5" @ 3745
TD 3788
S/1 1/2 bo 14 bw 20 hr
2000 A
S/9 bo 16 bw 11 hr
78 qt 3757-88
S/10 bo 19 bw 12 hr
TD 3832
S/52 bw 10 hr
D&A
ABANDONED


County Kingman State Kansas
 Sec. 1 (Blk.) 28 (Sur.) 5W Map No.
 Operator Cities Service
 Well No. 1 Farm Simons
 Elev. 1419 Location SW SW NW

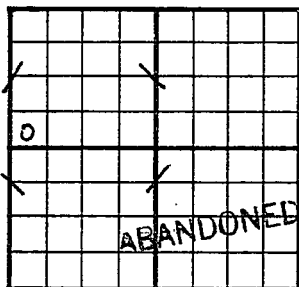

330 Ft. From S Line NW
330 Ft. From W Line Quarter
 Ist. Report
 Completion OCT 11 1950
 Remarks Wildcat
Barbour Drlg. - Contr.
 Spudding Date 8-29-50

Drlg. Data D & A - TD 3832
8" @ 209 Lans. 2894 Miss. chat 3736
Miss. dol. 3768-76 DST 3750-76
open 45 min. Rec. 80' mud DST 3768-88
open 45 min. Rec. 120' mud 5" @ 3745
TD 3788 S/ 1½ bo 14 bw 20 hr. 2000 A
S/ 9 bo 16 bw 11 hr. 78 qt. 3757-88
S/ 10 bo 19 bw 12 hr. TD 3832
S/ 52 bw 10 hr D & A

J. E. TYRA

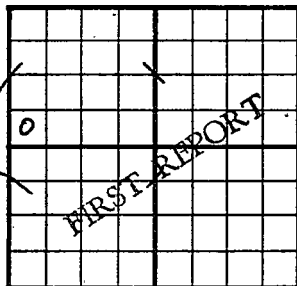County Kingman State KansasSec. 1 (Blk.) 28 (Sur.) 5W Map No.Operator Cities ServiceWell No. 1 Farm SimonsElev. _____ Location SW SW NW330 Ft. From S Line NW330 Ft. From W Line Quarter1st. Report AUG 30 1950

Completion _____

Remarks _____

Spudding Date _____

Drlg. Data WildcatLocation _____

J. E. TYRA