

KANSAS

Well No. #1 ~~Lexter~~ ^{Baxter}

Company Bennett & Roberts.

NORTH

WEST

EAST

0

SOUTH

Kingman KANSAS

SEC.	TWP.	R.
1	28	5W

WELL NO. **Baxter**
~~I-Lexter~~ FARM

COMPANY
 Contractor **Bennett & Roberts**


CONTRACTOR
 Co. Tools
 Bartholomew Pool

990 Ft. from N. Line

Ft. from S. Line

Ft. from E. Line

990 Ft. from W. Line

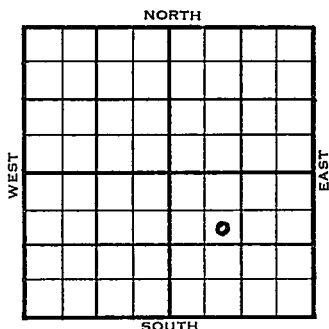


SE NW SE

	ELEVATION	REPORT
1955	1411'	

3/2 MIR

3/23 Spud 3-3-55, D&A, TD 3850
 8" @ 143, Miss 3741, DST 3779-
 3811, open 1 hr. Rec 200'
 GCMW 1025# TD 3850
 D&A

ABANDONED

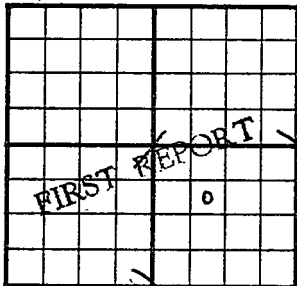County Kingman State KansasSec. 1 (Blk. Twp.) 28 (Sur. Rge.) 5W Map No.Operator Bennett & RobertsWell No. 1 Farm LexterElev. Location SE NW SE990 Ft. From N Line SE990 Ft. From W Line Quarter1st. Report MAR 2 1955

Completion

Remarks

Co. tools

Spudding Date

Drig. Data Bartholomew PoolM T R

FABEN GILSTRAP

SCOUT TICKET

DX-201

Kansas

SEC.

1

TWP.

28

R.

5W

WELL NO.

1 Baxter

FARM

COMPANY

Bennett & Roberts

CONTRACTOR

CORRECTION

SE NW SE

990


FT. FROM N. LINE

FT. FROM S. LINE

FT. FORM E. LINE

990

FT. FROM W. LINE

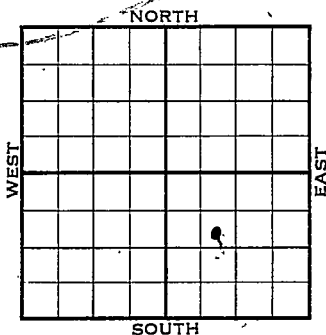

Kingman County

☐

LOCATION

☐

RIG UP

DRILLING AND REMARKS:

Reported
#1 Lexter

RECORD

CASED IN., FT.

SAND

GAS

OIL

TOTAL DEPTH

1ST 24 HRS. NAT.

1ST 24 HRS. AFTER SHOT

GAS

CU. FT.

DRY HOLE

ABANDONED


PRODUCTION

DATE

MAR 1 6 1955

SCOUT

FABEN GILSTRAP

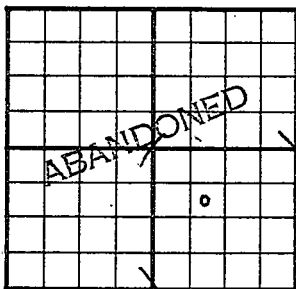County Kingman State KansasSec. 1 (Blk.) 28 (Sur.) 5W Map No.Operator Bennett & RobertsWell No. 1 Farm BaxterElev. 1411 Location SE NW SE990 Ft. From N Line SE990 Ft. From W Line Quarter1st. ReportCompletion MAR 23 1955Remarks Bartholomew PoolCo. toolsSpudding Date 3-3-55Drilg. Data D & A. TD 38508" @ 143 Miss. 3741 DST 3779-3811open 1 hr. Rec. 200' gcmw 1025#TD 3850D & A

FABEN GILSTRAP