

Section 1 Township 28 Range 5WWell No. #2 HardingCompany Westgate-Greenalnd

NORTH

WEST

							0

EAST

SOUTH

Kingman

KANSAS

Sec. 1 Twp. 28 R. 5W ✓

Well No. #2 Harding Farm

Westgate-Greenland Company

Jackson Drlg. - Contr. Contractor

Bartholomew Pool


 Ft. from N. Line

990' Ft. from S. Line

330' Ft. from E. Line

 Ft. from W. Line

NE SE NE

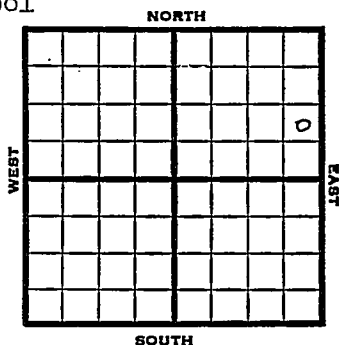

1950 Elev. 1418' REPORT

12/20 Location

1951
2/28 Spud 1-9-51
Oil Well TD 3795
8" @ 202 Br Lime 2860
Lans. 2907 Miss Chat 3727
Dol. 3774
5" ^u 3767 TD 3791
2000 A 28/3765-79
1000 A wtr DD 3795½
SP 3792½ CO to 3795
1000 A 40 bopd Comp. 22 bopd

COMPLETED

County Kingman State Kansas
 Sec. 1 (Blk. 28 (Sur. 5W Map No.
 (Twp.) (Rge.)
 Operator Westgate-Greenland
 Well No. 2 Farm Harding
 Elev. Location NE SE NE


							0

FIRST REPORT

990 Ft. From S Line NE
330 Ft. From E Line Quarter
 Ist. Report DEC 20 1950
 Completion
 Remarks
Jackson Drlg. - Contr.
 Spudding Date

Drlg. Data Bartholomew Pool
 Location

County Kingman State Kansas
 Sec. 1 (Blk.) 28 (Sur.) 5W Map No.
 Operator Westgate-Greenland
 Well No. 2 Farm Harding
 Elev. 1418 Location NE SE NE

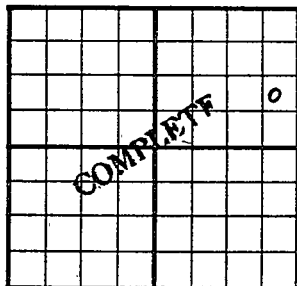

990 Ft. From S Line NE
330 Ft. From E Line Quarter
 Ist. Report
 Completion FEB 28 1951
 Remarks Bartholomew Pool
Jackson Drlg. - Contr.
 Spudding Date 1-9-51

Drlg. Data Oil well TD 3795
8" @ 202 Br. lime 2860 Lans. 2907
Miss. chat 3727 Dol. 3774 5" @ 3767
TD 3791 2000 A 28/ 3765-79 1000A
water DD 3795 $\frac{1}{2}$ SP 3792 $\frac{1}{2}$ CO to 3795
1000 A 40 bopd Comp. 22 bopd

J. E. TYRA