



Sec. 1 Twp. 28 R. 5W

Well No. #1 Harding Farm

Westgate-Greenland Company

Jackson Drlg. - Contr. Contractor

Bartholomew Pool


660' Ft. from N. Line

\_\_\_\_\_ Ft. from S. Line

330' Ft. from E. Line

\_\_\_\_\_ Ft. from W. Line

C E L NE NE

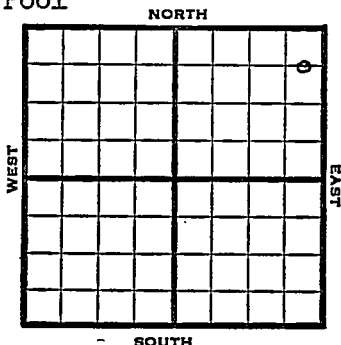

1950

Elev 1422' REPORT

11/1

Cellar & Pits

1951

1/10

Spud 11-6-50

8" @ 200

Br lime 2864

Lans 2915

Miss chat 3725

TD 3773

5" @ 3766

1000 A F/53 bo 3 hr

Miss dol 3765

DST 3765-73 opn 1/2 hr rec 30' oil

35' ocm

Comp 52 bopd 15% water

Completed

**COMPLETED**

County Kingman State Kansas

Sec. 1 (Blk. 28) (Sur. 5W) (Twp.) (Rge.) Map No.

Operator Westgate-Greenland

Well No. 1 Farm Harding

Elev. Location C. E. L. NE NE


660 Ft. From N Line NE

330 Ft. From E Line Quarter

Ist. Report NOV 1 1950

Completion

Remarks

Jackson Drlg. - Contr.

Spudding Date

Drlg. Data Bartholomew Pool

Cellar & pits

J. E. TYRA

