

Sedgwick

FORM 51 5M 4-41 PETROL


Section 1 Township 28 Range 4-W

Well No. #1 Puetz

Company Ruso Drilling et al

Wildcat

NORTH

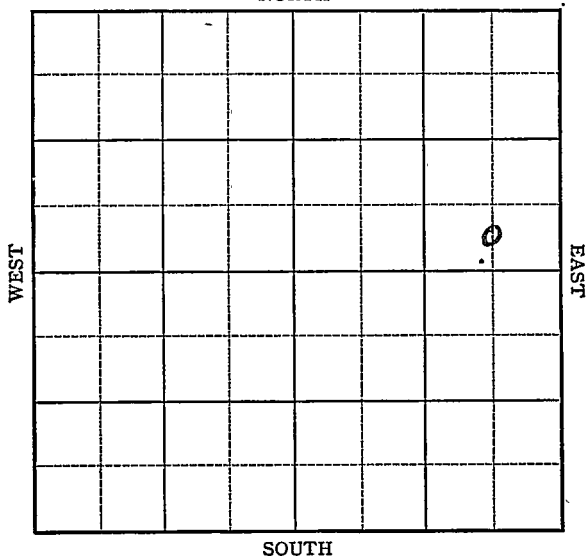

SOUTH


Sedgwick

Map No. 37 Sec. 1 Twp. 28 R. 4WWell No. 1 PuetzRuso Drilling etal. Company**FIRST REPORT**

Contractor

C S L S E N E

SECTION PLAT

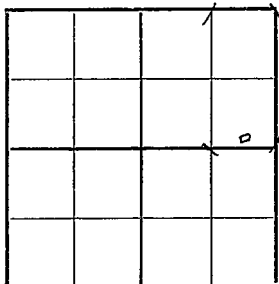 Ft. from N. Line330 Ft. from S. Line660 Ft. from E. Line Ft. from W. LineWILDCATLocation Rig up

Drilling and Remarks:

Derrick

RECORD

Cased in., ft.Sand Gas Oil Total Depth

PRODUCTION

1st 24 hrs. Nat. 1st 24 hrs. after shot Gas Cu. Ft.Dry Hole Abandoned

Date

JUN 17 1942 19 S. J. LEWIS Scout

KANSAS

Sedgwick

Map No. 37 Sec. 1 Twp. 28 R. 4WWell No. 1 PuetzRuso Drilling et al. CompanyABANDONED Contractor

C S L S E N E

SECTION PLAT

			a

_____ Ft. from N. Line

330 Ft. from S. Line660 Ft. from E. Line

_____ Ft. from W. Line

WILDCAT

RECORD

Location _____

Cased _____ in., _____ ft.

Rig up _____

Sand _____

Drilling and Remarks:

Gas _____

Oil _____

Total Depth 4947

PRODUCTION

1st 24 hrs. Nat. _____

1st 24 hrs. after shot _____

Gas _____ Cu. Ft.

Dry Hole _____

Abandoned _____

Balis 4075
Imp 4244
Le Y 4332
Nashua

Date

JUL 22 1942 19 S. J. LEWIS Scout