


Haskell

KANSAS

DX 78-1

Section 1 Township 28 Range 33W
Well No. #1 Anschutz
Company Southwestern Explor.

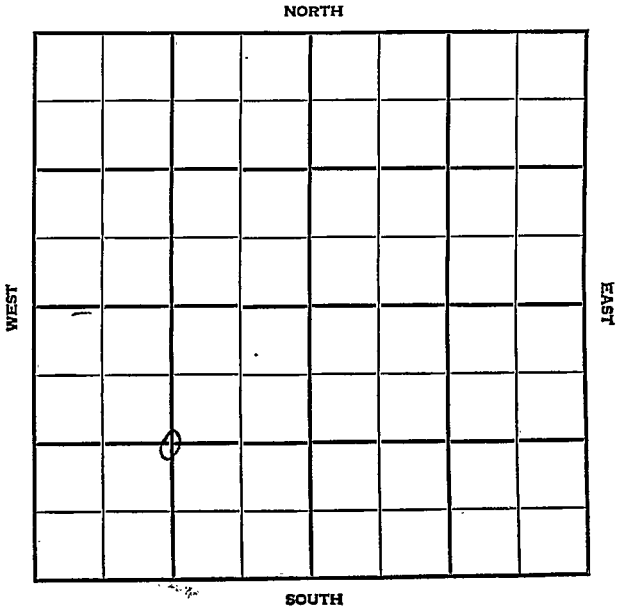

SEC.	1	TWP.	28	R.	33W
------	---	------	----	----	-----

WELL NO.

#1 Anschutz

FARM

COMPANY

Southwestern Expl.

CONTRACTOR

Rocket Drlg.

Hugoton Pool


NORTH

Ft. from N. Line

1320 Ft. from S. Line

Ft. from E. Line

1320 Ft. from W. Line

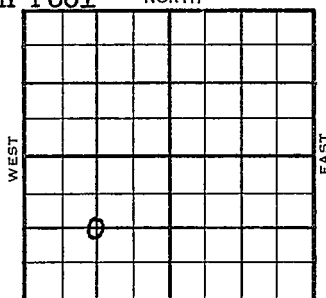

C SW/4

	ELEVATION	REPORT
1955	2962'	

4/13

Location

6/15

Comm. 4-25-55

8 5/8" @552/400 5 1/2" @ 2810/250

CO 40/2774-84, SSG 1000 A F/500 mcfg

1,500 mcfg frac 1,800 mcfg 3 1/2 bfp/h 36hr.

1,500 mcfg frac plug to bottom 3 hr.

open flo, 11,220 mcfg PB 2744 120/2720

-40 Comp. 11,200 mcfgpd 385#

M. Winf. 2771

TD. 2810

COMPLETED

FABEN GILSTRAP

County Haskell Elev. 2964 RB
 Sec. 1 Twp. 28 Rge. 33W
 Company Southwestern Explor.
 Farm Name Anschutz No. 1

TOPS	DEPTH	LOG	DATUM	Loc. in Sec.
Anh.				C SW/4
Tr.				
H.				
Tr.				
Dg.				
BL.				
L.				Geol.
K.C.				Contr.
B.K.C.				
Ce.				
C.				
M. <u>Winf</u>	<u>2771</u>			Rocket
M.				Pool
K.				
Mz.				Hugoton
Me.				
V.				
S.				
S.				
A.				
R.				
Pe.				
G.				
T.D.	<u>2810</u>			

Date Comm. 4-25-55

JUN 15 1955

8 5/8" @ 552/400 5 1/2" @ 2810/250CO 40/ 2774-84 SSG 1000 AF/ 500@cmcfgr 1,500 mcfgr frac1,800 mcfgr 3 1/2 bfph 36 hr. 1,500 mcfgrfrac plug to bottom 3 hr. open flow11,220 mcfgr PB 2744 120/ 2720-40Comp. 11,200 mcfgrpd 385#