


Section 1 Township 28 Range 21-WWell No. #1 HarshaCompany Republic Natural Gas etal

NORTH

WEST

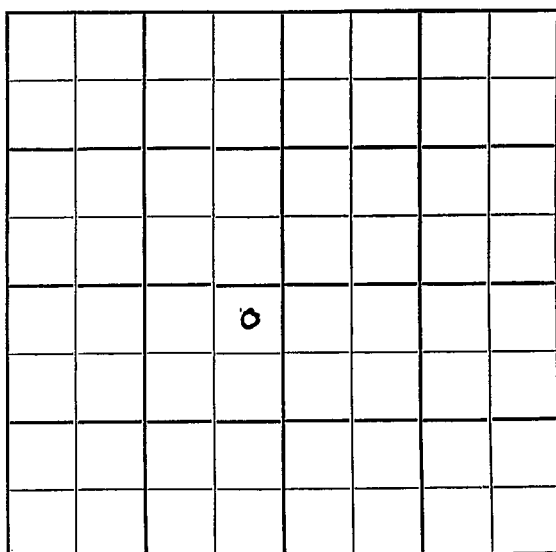

EAST

SOUTH

Sec. 1 Twp. 28 R. 21W

Well No. #1 Harsha Farm

Republic Natural Gas et al Company

Moran Drlg. Contractor

Wildcat


330' Ft. from N. Line

Ft. from S. Line

330' Ft. from E. Line

Ft. from W. Line

NE NE SW

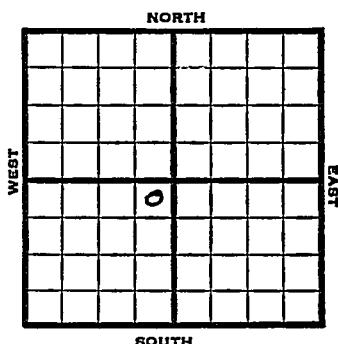

1951

Elev. 2352' REPORT

1/10 Drlg.

3/21 Spud 1-13-51 D & A TD 5005'
10" @ 443', Her. 2585', Hol. 2473',
Lans. 4315', Miss. 4962',
DST 4946-66' open 1 hr. Rec. 200' mud,
DST 4969-5005, 573,000 gas in 12 min.
773,000 gas in 27 min. lpen 4 hr. Rec.
1440' water, 420' GCM, 7" @ 5003',
20/ 4968-73', 12/ 4977-81',
16/ 4977-81, 12/ 4969-73', 2000 A
50,000 CFG & SW, SP 4096',
52/ 4664-77 500 A
D & A

ABANDONED

County **Ford** State **Kansas**

Sec. **1** (Blk. **28** (Sur. **21W** Map No.

Operator Republic Natural Gas etal.

Well No. **1** Farm **Harsha**

Elev.	Location	NE	NE	SW

0

FIRST REPORT

330 Ft. From N Line SW

330 Ft. From E Line Quarter

1st. Report JAN 10 1951

Completion


Remarks	Miss. test
---------	------------

Spudding Date _____

Drig. Data **Wildcat**

drlg.

J. E. TYRA

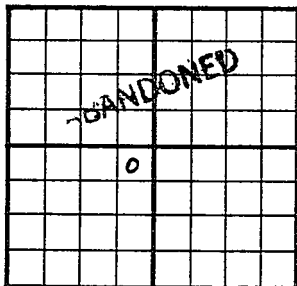County Ford State KansasSec. 1 (Blk. Twp.) 28 (Sur. Rge.) 21W Map No. _____Operator Republic Natural GasWell No. 1 Farm HarshaElev. 2352 Location NE NE SW330 Ft. From N Line SW330 Ft. From E Line Quarter

1st. Report _____

Completion MAR 21 1951Remarks WildcatMoran Drlg. - Contr.Spudding Date 1-13-51Drlg. Data D & A TD 500510" @ 443 Her. 2585 Hol. 2473Lans. 4315 Miss. 4962 DST 4946-66open 1 hr. Rec. 200' mud DST 4969-5005573000 gas in 12 min. 773000 gas in 27 minopen 4 hr. Rec. 1440' water 420' gcm7" @ 5003 20/ 4968-73 12/ 4977-8116/ 4977-81 12/ 4969-73 2000 A50000 cfg & sw SP 4096 52/ 4664-77500 AD & A

J. E. TYRA