

# KANSAS

Form 51-5M-7-39-Palace


Pratt

Section 1 Township 28 Range 11-W

Well No. #1 Krehbiel "B"

Company Skelly

NORTH Cunningham Pool

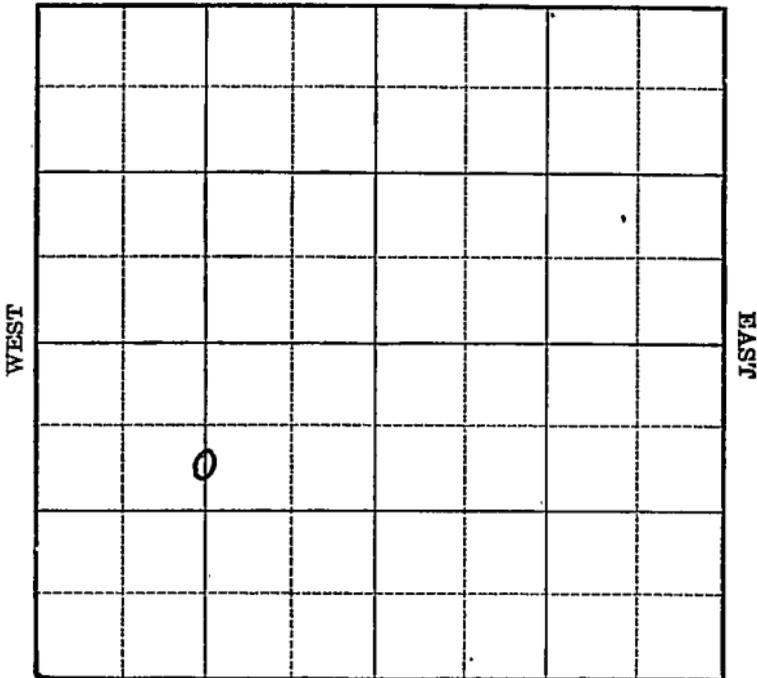

SOUTH

Sec. 1 Twp. 28 R. 11-WWell No. #1 Krehbiel "B" FarmSkelly Company

(Cunningham)


990 Ft. from N. Line

\_\_\_\_\_ Ft. from S. Line

\_\_\_\_\_ Ft. from E. Line

1320 Ft. from W. Line

Elev. 1749

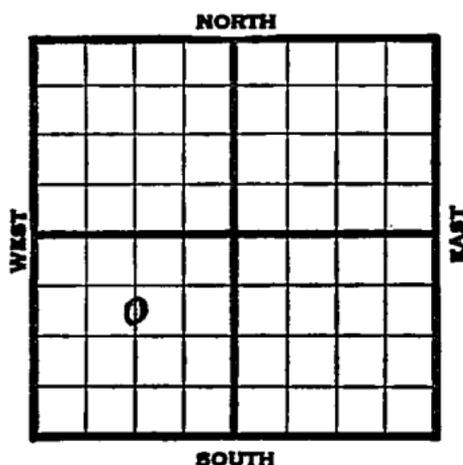

## REPORT

1940	
1/3	Location
1/11	Rotary.
1/18	10" - 351' WOC.
1/25	Drlg. 2225'
2/1	Drlg. 3290'
2/8	Drlg. 3940'
2/15	Kinderhook 4146' Viola 4207½'
	T.D. 4209' 5½" - 4208½' RUST.
2/23	T.D. 4223' 1000 acid.
	41½ M cu. ft. gas.
	Shut down.
2/29	" "
3/8	" "
3/13	Viola 4207½'
	5½" - 4208½'
	T.D. 4223'
	1000 acid.
	29,400,000 cu. ft. gas.

COMPLETED

Map No. 54 Sec. 1 Twp. 28 R. 11WWell No. 1 Krehbiel "B"Skelly

Company

Contractor

## FIRST REPORT

C S L N $\frac{1}{2}$  SW990 Ft. from N. Line


\_\_\_\_\_ Ft. from S. Line

\_\_\_\_\_ Ft. from E. Line

1320 Ft. from W. Line

CUNNINGHAM POOL

## SECTION PLAT

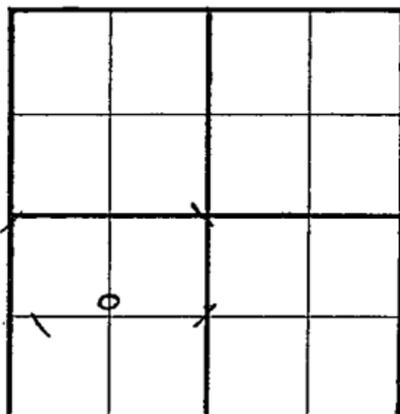Location X

Rig up \_\_\_\_\_

Drilling and Remarks:

## RECORD

Cased \_\_\_\_\_ in., \_\_\_\_\_ ft.

Sand \_\_\_\_\_

Gas \_\_\_\_\_

Oil \_\_\_\_\_

Total Depth \_\_\_\_\_

## PRODUCTION

1st 24 hrs. Nat. \_\_\_\_\_

1st 24 hrs. after shot \_\_\_\_\_

Gas \_\_\_\_\_ Cu. Ft.

Dry Hole \_\_\_\_\_

Abandoned \_\_\_\_\_

Date

JAN 3 1940

19

Scout

# KANSAS


Form 26—200 Bks.—1-40—Palace

Pratt

Map No. 54 Sec. 1 Twp. 28 R. 11WWell No. 1 Krehbiel "B"Skelly Oil

Company

Contractor

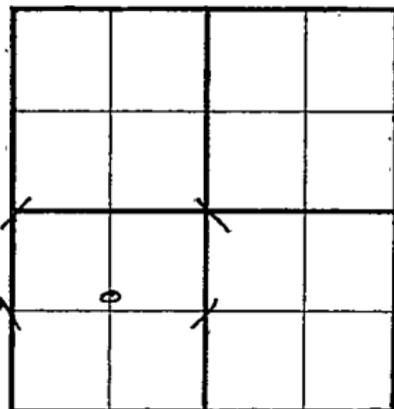**COMPLETED****C S L  $N\frac{1}{2}$  SW****SECTION PLAT**990 Ft. from N. Line

\_\_\_\_\_ Ft. from S. Line

\_\_\_\_\_ Ft. from E. Line

1320 Ft. from W. Line**CUNNINGHAM POOL**

Location \_\_\_\_\_

Rig up \_\_\_\_\_

Drilling and Remarks:

*Vista 420 1/2*  
*5 1/2" @ 420 1/2*  
*1000 acid*

*29,400,000 gas*

**RECORD**

Cased \_\_\_\_\_ in., \_\_\_\_\_ ft.

Sand \_\_\_\_\_

Gas \_\_\_\_\_

Oil \_\_\_\_\_

Total Depth 4223**PRODUCTION**

1st 24 hrs. Nat. \_\_\_\_\_

1st 24 hrs. after shot \_\_\_\_\_

Gas \_\_\_\_\_ Cu. Ft.

Dry Hole \_\_\_\_\_

Abandoned \_\_\_\_\_

Date

MAR 13 1940 19S. J. LEWIS Scout