



Kingman

KANSAS

DX 78-1

Section 10 Township 28S Range 5W
Well No. #1 Wulf
Company Beardmore-Brann & O.A. Sutton

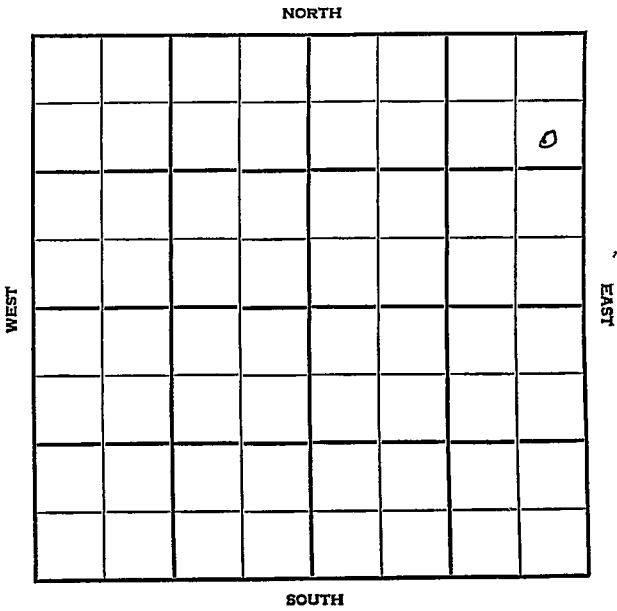

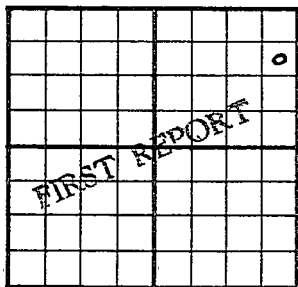County Kingman State KansasSec. 10 (^{Blk.}
Twp.) 28S (^{Sur.}
Rge.) 5W Map No.Operator Beardmore-Brann & O.A. SuttonWell No. 1 Farm WulfElev. Location SE NE NE990 Ft. From N Line330 Ft. From E Line NE Quarter1st. Report DEC 8 1954

Completion

Remarks Beardmore tools


Spudding Date

Drlg. Data

CasleyRURT

FABEN GILSTRAP

County Kingman State Kansas
 Sec. 10 (Blk.) 28 (Sur.) 5W Map No.
 Operator Beardmore-Brann & O. A. Sutton
 Well No. 1 Farm Wulf
 Elev. 1420 Location SE NE NE

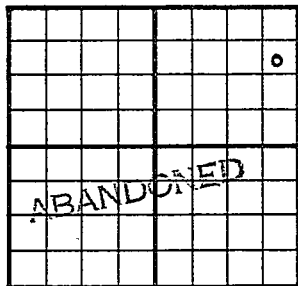

990 Ft. From N Line NE
330 Ft. From E Line Quarter
 Ist. Report
 Completion DEC 22 1954
 Remarks Casley Pool
Beardmore - Contr.

Spudding Date 12-9-54
 Drilg. Data D & A TD 3850
8" @ 160 Lans. 2962 B KC 3408
Miss. 3773 DST 3795-3820 open 1. hr.
Rec. 120' gcm 30' gcm 1112# TD 3850
D & A

FABEN GILSTRAP