


Section 10 Township 28 Range 35W

Well No. #1 Drew "C"

Company Columbian Fuel

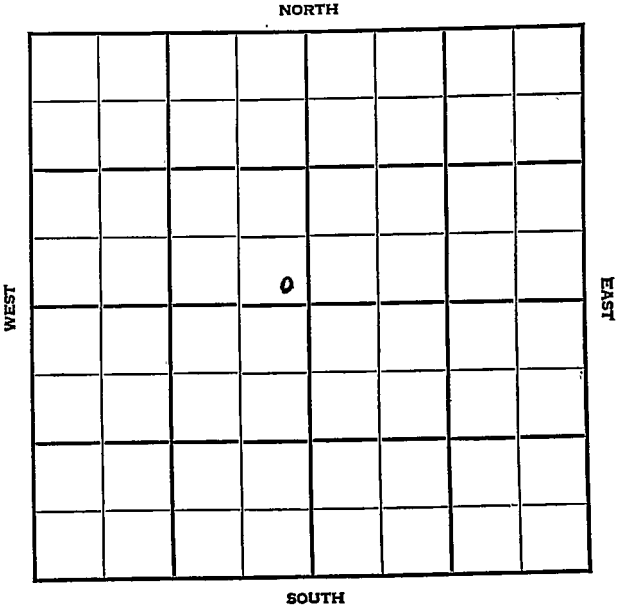

Sec. 10 Twp. 28 R. 35W

Well No. #1 Drew "C" Farm

Columbian Fuel Company

Hugoton


 Ft. from N. Line

100 Ft. from S. Line

100 Ft. from E. Line

 Ft. from W. Line

SE NW

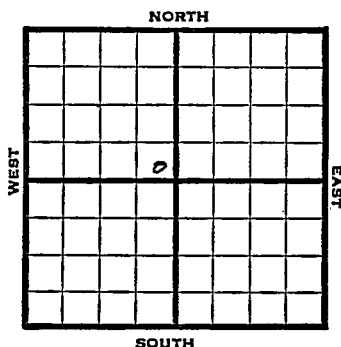

1947

Elev. 3084' REPORT

10/1	Location
10/8	"
10/15	10" @ 600' WOC
10/22	TD 2640 7" @ 2613
10/29	TD 2817'
11/5	"
11/12	208' of 5" Perf. liner @ 2817'
11/19	15,000 Acid
11/25	"
12/3	7" @ 2613' 208' of 5" Perf liner @ 2817' Acid 15,000 Gas 24,256,000 Rock Pr. 403# Total Depth 2877' COMPLETED

Map No. _____ Sec. 10 Twp. 28 R. 35W

Well No. 1 Drew "C"

Columbian Fuel Company

FIRST REPORT

Contractor _____

SE NW

SECTION PLAT

_____ Ft. from N. Line

100 Ft. from S. Line

100 Ft. from E. Line

_____ Ft. from W. Line

	6		

Grant County

Location X

Rig up _____

Drilling and Remarks:
 f

RECORD

Cased _____ in., _____ ft.

Sand _____

Gas _____

Oil _____

Total Depth _____

PRODUCTION

1st 24 hrs. Nat. _____

1st 24 hrs. after shot _____

Gas _____ Cu. Ft.

Dry Hole _____

Abandoned _____

Date

OCT 1 1947 19

S. J. LEWIS Scout

Map No. _____ Sec. 10 Twp. 28 R. 35W

Well No. 1 Drew "C"

Columbian Fuel Company

COMPLETE

Contractor

SE NW

E 13084
SECTION PLAT

_____ Ft. from N. Line

100 Ft. from S. Line

100 Ft. from E. Line

_____ Ft. from W. Line

Grant County

Location _____

Rig up _____

Drilling and Remarks:

7" @ 2613
208' by 5" Pipe line
@ 2717
15000 rods
24,256,000 Gas
463 # R₂

RECORD

Cased _____ in., _____ ft.

Sand _____

Gas _____

Oil _____

Total Depth 2872

PRODUCTION

1st 24 hrs. Nat. _____

1st 24 hrs. after shot _____

Gas _____ Cu. Ft.

Dry Hole _____

Abandoned _____

Date

DEC 3 1947 19

S. J. LEWIS Scout