

DX 78-1


Haskell

KANSAS

Section 10 Township 28 Range ~~32 W~~
~~34 W~~

Well No. # 1 Schuette "B"

Company Michaelis Drlg.

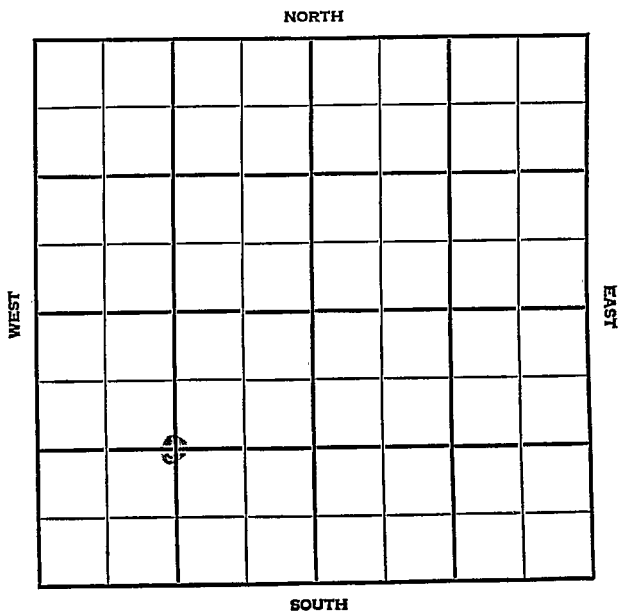

Finney Haskell

KANSAS

SEC.	TWP.	R.
10	26 28	32W

WELL NO.

1 Schutte "B"

FARM

COMPANY

Michaelis Drlg.

CONTRACTOR

Co. Tools

Hugoton


Ft. from N. Line

Ft. from S. Line

Ft. from E. Line

Ft. from W. Line

C SW/4

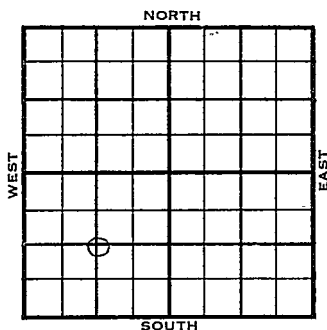

Northern Nat - FO

1955

ELEVATION

REPORT

5/26

M I R

8/3

Comm 6-7-55

8 5/8" @ 574 w/300 sks;

5 1/2" @ 2766 CO 60/2738-50;

Frac; op flo 2,716,000 cfg.

72-20 7,064,000 cfg

RP 419#

Herr. 2685, 2685

Tr. Kri 2711

Dg L Kri 2738

TD. 2767

COMPLETED

Top 1/2 of 1st 1/2
Co. 1/2 of 1st 1/2
K-35

FORM 513 REV. SUNRAY

28 correct sam
FIRST REPORT


Elev.

Sec. 10

Twp. 28

Rge. 32W

Company Michaelis Drlg.

Farm Name Schuetta "B"

No. 1

TOPS

DEPTH

LOG

DATUM

Loc. in Sec.

Anh.			
TP.			
H.			
Tr.			
Dg.			
BL.			
L.			
K.C.			
B.K.C.			
Ce.			
C.			
M.			
M.			
K.			
Mz.			
Mo.			
V.			
S.			
S.			
A.			
R.			
Pe.			
G.			
TD.			

C SW/4

Geol.

Contr.

Co. tools

Pool

Hugoton


M I R

K-35

County Haskell Elev. _____
 Sec. 10 Twp. 28S Rge. 32W
 Company Michaelis Drlg.
 Farm Name Schuette "B" No. 1

TOPS	DEPTH	LOG	DATUM
Anh.			
Tp.			
H. <u>Herr</u>	<u>2685</u>	<u>2685</u>	
Tr. <u>U. R.</u>	<u>2711</u>		
Dg. <u>L. R.</u>	<u>2738</u>		
BL.			
L.			
K.C.			
B.K.C.			
Ce.			
C.			
M.			
M.			
K.			
Mz.			
Me.			
V.			
S.			
S.			
A.			
R.			
PE.			
G.			
T.D.	<u>2767</u>		

Loc. in Sec. _____

C SW/4

No. Nat. FO

Geol. _____

Contr. _____

Co. tools

Pool

Hugoton

COMPLETE		
1906	3	1955

Date Comm. 6-7-55; 8-5/8" 574 w/300 sx;
5 1/2" 2766; CO; 60/2738-50; frac; op flo

2,716,000 cfg

72-20 7,064,000 cfg

RP 419#