

KANSAS


FORM 51 5M BRIX

Pratt County

Section 10 Township 28 Range 11W

Well No. #1 Morrison "C"

Company Skelly

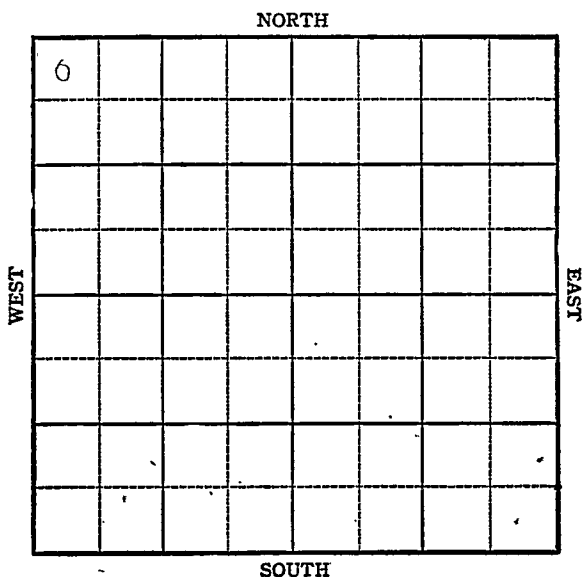

KANSAS

Sec. 10 Twp. 28 R. 11W

Well No. 1 Morrison "C" Farm

Skelly Company

Cunningham


NORTH

330 Ft. from N. Line

 Ft. from S. Line

 Ft. from E. Line

330 Ft. from W. Line

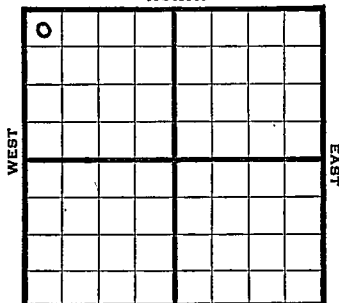

SOUTH

Elev. 1773

1944

REPORT

7/5

Loc.

7/12

"

7/19

Drlg 500

7/26

Drlg. 1380'

8/2

Drlg. 2930 8" @ 384

8/9

Lans 3556-70 TD 5" @ 3560 RUST

8/16

" " " " " " " "

8/23

" " " " " " " "

8/30

" " " " " " " "

9/8

" " " " " " " "

9/13

" " " " " " " "

9/21

" " " " " " " "

9/28

" " " " " " " "

10/4

" " " " " " " "

10/11

Lans 3559 corrected

5" @ 3563 TD 3600

1000' oil in 3 hrs.

10/18

1000' acid No test

10/25

" " " "

11/8

Lans 3559

5" @ 3563

1000 acid

Pump 60 Pot.

TD 3600


Grav. 36.

COMPLETED

Pool Name Cunningham**KANSAS**Map No. 5 Sec. 10 Twp. 28 R. 11WWell No. 1 Morrison "C"Skelly CompanyFIRST REPORT Contractor

NW/C

SECTION PLAT

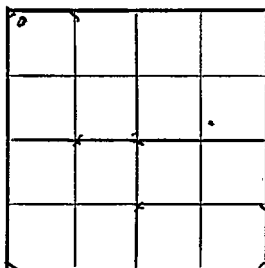330 Ft. from N. Line Ft. from S. Line Ft. from E. Line330 Ft. from W. Line

Pratt County

Location XRig up

Drilling and Remarks:

RECORD

Cased in., ft.Sand Gas Oil Total Depth

PRODUCTION

1st 24 hrs. Nat. 1st 24 hrs. after shot Gas Cu. Ft.Dry Hole Abandoned

Date

JUL 5 1944 19 S. J. LEWIS Scout

Pool Name CunninghamMap No. 54 Sec. 10 Twp. 28 R. 11WWell No. 1 Morrison "C"Skelly

Company

COMPLETED

Contractor

NW/c

SECTION PLAT

6			

330 Ft. from N. Line Ft. from S. Line Ft. from E. Line330 Ft. from W. LinePrattLocation Rig up

Drilling and Remarks:

2 are 35595' 35631000 acidPump 60 RT360 ft

RECORD

Cased in., ft.Sand Gas Oil Total Depth 3600

PRODUCTION

1st 24 hrs. Nat. 1st 24 hrs. after shot Gas Cu. Ft.Dry Hole Abandoned

Date

NOV 8 1944 19S. J. LEWIS

Scout