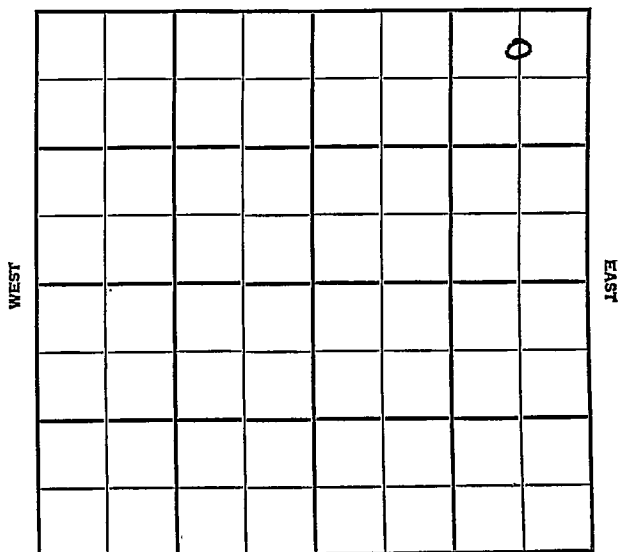


Section 11 Township 28 Range 5WWell No. 1 Casley "A"Company Pickrell Drlg. & Franco Central

NORTH



SOUTH

SEC.	TWP.	R.
11	28	5W

WELL NO.

#1 Casley "A"

FARM

COMPANY

Pickrell Drlg. & Franco Central

CONTRACTOR

Co. Tools.

Casley Pool

330

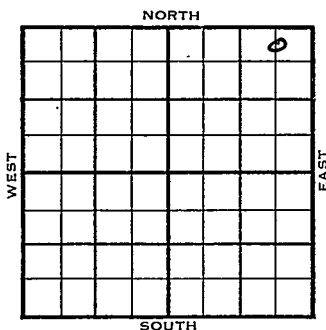
Ft. from N. Line

Ft. from S. Line

660

Ft. from E. Line

Ft. from W. Line

C N $\frac{1}{2}$ NE NE

1954

ELEVATION

1408'

REPORT

11/17

MIR

12/1

Spud 11-18-54

D & A TD 3826 8-5/8" @ 160

Miss. 3741

DST 3753-80 open 1 hr rec 65' thin

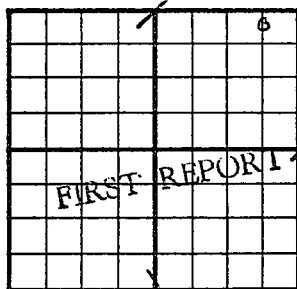
GCM 810#

DST 3781-95 open 1 hr rec 185' mud &

SW 1500# TD 3826

D & A

ABANDONED

County Kingman State KansasSec. 11 (Blk.) 28 (Sur.) 5W Map No.Operator Pickrell Drlg. & Franco CentralWell No. 1 Farm Casley "A"Elev. Location C N¹/₂ NE NE330 Ft. From N Line NE660 Ft. From E Line Quarter1st. Report NOV 17 1954

Completion

Remarks

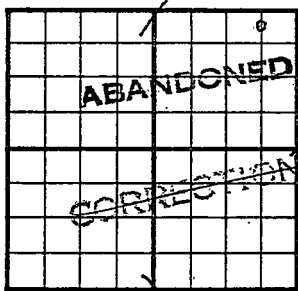
Co. tools

Spudding Date

Drlg. Data Casley PoolM I R

FABEN GILSTRAP

Kansas

County Kingman StateSec. 11 (Blk.
Twp.) 28 (Sur.
Rge.) 5W Map No.Operator Pickrell Drlg. & Franco CentralWell No. 1 Farm Casley "A"Elev. 1408 Location C N $\frac{1}{2}$ NE NE330 Ft. From N Line NE660 Ft. From E Line Quarter

1st. Report

Completion DEC 1 1954Remarks Casley PoolCo. toolsSpudding Date 11-18-54Drlg. Data D & A TD 38268 5/8" @ 160 Miss. 3741 DST 3753-80open 1 hr. Rec. 65' thin gcm 810#DST 3781-95 open 1 hr. Rec. 185' mud &sw 1500# TD 3826D & A

FABEN GILSTRAP