

Section 11 Township 27.28 Range 5 WWell No. # 4 CasleyCompany Walgreen & Stuart
Beardmore Delg.

NORTH

	0						

WEST

EAST

SOUTH

Kingman KANSAS

SEC. 11 TWP. 28 R. 5W ✓

WELL NO.

4 Casley

FARM

COMPANY

WALGREEN STUART

Beardmore Drlg.

CONTRACTOR

Beardmore

Casley Pool

Ft. from N. Line

990


Ft. from S. Line

Ft. from E. Line

990

Ft. from W. Line

NORTH

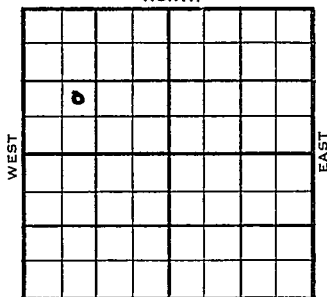

SOUTH

NE SW NW

ELEVATION

REPORT

1954

1113

4/21

Spud 4-17-54
8" @ 153'
Drlg. 970'

6/30

32-28-13W
1 Mc Minn Se SE NE
MIR

12/7

Spudding 4-17-54
Oil well
TD 3802
8" @ 153
Miss. 3736 Dol. 3770
DST 3783-99 open 1 hr. Rec. 90' gcm
1330#
TD 3799
5" @ 3792 CO 3799 500 ZA 1 boph
5% wtr. DD 3802 2000 A S. 20 bopd
Comp. 48 bopd 60% wtr.

COMPLETED

County Kingman State Kansas

Sec. **11** (Blk.) **27** (Sur.) **5W** Map No.

Operator **Beardmore Drlg.**

Well No. 4 Farm Casley

Elev.	Location	NE	SW	NW
-------	----------	----	----	----

0

FIRST REPORT

990 Ft. From S Line NW

990 Ft. From ~~the~~ Line Quarter

1st. Report APR 21 1954

Completion _____

Remarks

Beardmore - Contr.

Spudding Date **4-17-54**

Drig. Data Casley Pool

8" @ 153 d1g. 970

Map No. _____ Sec. 11 Twp. 28 R. 5WWell No. 4 Casley

_____ Beardmore Drlg. _____ Company

CORRECTION

_____ Contractor

NE SW NW

SECTION PLAT

_____ Ft. from N. Line

990 Ft. from S. Line

_____ Ft. from E. Line

990 Ft. from W. Line

o			

Kingman County

Location _____

Rig up _____

Drilling and Remarks:

Reported

11-27-5W

RECORD

Cased _____ in., _____ ft.

Sand _____

Gas _____

Oil _____

Total Depth _____

PRODUCTION

1st 24 hrs. Nat. _____

1st 24 hrs. after shot _____

Gas _____ Cu. Ft.

Dry Hole _____

Abandoned _____

Date

APR 28 195419J. G. McGEHEEScout

Actuals

Map No. _____ Sec. 11 Twp. 28 R. 5W

Well No. 4 Casley

Walgreen & Stuart Company

CORRECTION Contractor

NE SW NW

SECTION PLAT

_____ Ft. from N. Line

990 Ft. from S. Line

_____ Ft. from E. Line

990 Ft. from W. Line

o			

Kingman County

Location _____

Rig up _____

Drilling and Remarks:

Reported

Beardmore D_rlg.

11-27-5W

RECORD

Cased _____ in., _____ ft.

Sand _____

Gas _____

Oil _____

Total Depth _____

PRODUCTION

1st 24 hrs. Nat. _____

1st 24 hrs. after shot _____

Gas _____ Cu. Ft.

Dry Hole _____


Abandoned _____

Date

MAY

5 1954 19

J. G. McGEHEE Scout

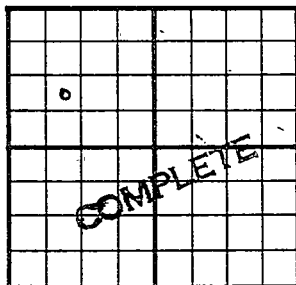County Kingman State KansasSec. 11 (Blk.
Twp.) 28 (Sur.
Rge.) 5W Map No.Operator Walgreen & StewartWell No. 4 Farm CasleyElev. 1413 Location NE SW N W990 Ft. From S Line NW990 Ft. From W Line Quarter1st. ReportCompletion JUL 7 1954Remarks Casley PoolBeardmore - Contr.Spudding Date 4-17-54Drlg. Data Oil well TD 38028" @ 153 Miss. 3736 Dol. 3770DST 3783-99 open 1 hr. Rec. 90' gcm1330# TD 3799 5" @ 3792 CO to 3799500 A 1 boph 5% wtr. DD 38022000 A S/ 20 bopdComp. 48 bopd 60% wtr.

J. G. McGEHEE