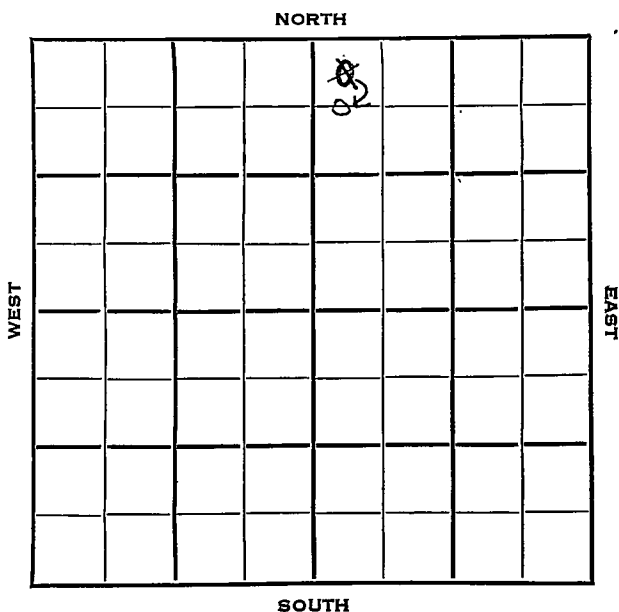


Section 11 Township 28 Range 5 WWell No. # 1 Brown "B"Company B & R Drlg.

Kingman

KANSAS

SEC.	TWP.	R.
11	28	5 W

WELL NO.

1 Brown "B"

FARM

COMPANY

B & R Drlg.

CONTRACTOR

B & R

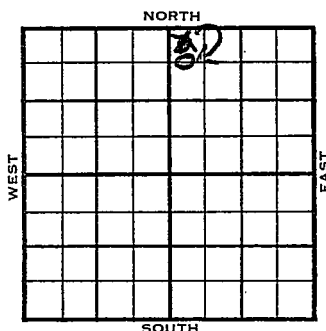
Gasley Pool

~~330-660~~ Ft. from N. Line

Ft. from S. Line

Ft. from E. Line

330 Ft. from W. Line

~~NW NW NE~~

CWL NW NE

	ELEVATION	REPORT
1953	B 98'	

10/14	Spud 10-7-53 8" @ 172 Drlg. 2175'	
10/21	Heeb 2651, Br. L. 2923, Lans 3145 Miss 3732, DST 3741*62' 1 hr, 45' M 390# Drlg.	
10/28	RTD 3790' 5" @ 3788'	
11/4	CO 3790	
11/11	1 boph 500 A P/ 35 BO / 90 BW.	
11/18	Spud 10-7-53 Oil well TD 3790 8" @ 172 Heeb 2651 Lans 2923 KC 3145 Miss. 3722 DST 3741-62 open 1 hr rec 45' mud 390# TD 3790 5" @ 3788 CO to 3790 1 BOPH 500 A P/35 BO 90 BW 500 A Comp. 35 BOPD 90 BW	

COMPLETED

J. G. McGEHEE

Scout Cards	mm
Land Small Map	
Land Wall Map	3
Tracings	
France Map	
Pierce Map	
Misc.	

OCT 16 1953

Drig. Data

Map No. _____ Sec. 11 Twp. 28 R. 5WWell No. 1 Brown "B"

B & R Drlg. _____ Company

CORRECTION _____ Contractor

C W L NW NE

SECTION PLAT

		o	

660 Ft. from N. Line

_____ Ft. from S. Line

_____ Ft. from E. Line

330 Ft. from W. Line

Kingman County

Location _____

Rig up _____

Drilling and Remarks:

Reported
NW NW NE

RECORD

Cased _____ in., _____ ft.

Sand _____

Gas _____

Oil _____

Total Depth _____

PRODUCTION

1st 24 hrs. Nat. _____

1st 24 hrs. after shot _____

Gas _____ Cu. Ft.

Dry Hole _____

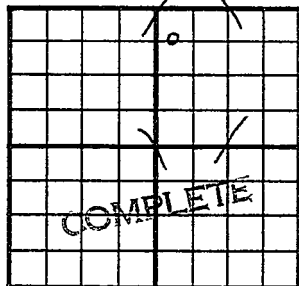
Abandoned _____

Date

OCT 21 1953 19 J. G. McGEHEE Scout

Scout Cards 21.00
Land Small Map
Land Wall Map
Tracings
France Map
Place Map
Misc.

OCT 27 1953

County Kingman State KansasSec. 11 (Blk. Twp.) 28 (Sur. Rge.) 5W Map No.Operator B & R Drlg.Well No. 1 Farm Brown "B"Elev. 1398 Location C W L NW NE660 Ft. From N Line NE330 Ft. From W Line Quarter

1st. Report

Completion NOV 18 1953Remarks Casley PoolB & R Drlg. - Contr.Spudding Date 10-7-53Drlg. Data Oil well TD 37908" @ 172 Heeb. 2651 Lans. 2923KC 3145 Miss. 3722 DST 3741-62open 1 hr. Rec. 45' mud 390#TD 3790 5" @ 3788 CO to 37901 boph 500 A P/ 35 bo 90 bw 500 AComp. 35 bopd 90 bw

J. G. McGEHEE

Scout Cards

Land Small Map

Land wall map

Tracings

France Map

Pierce Map

Misc:

NOV 24 1953

Orig. Data