

Grant County

FORM 51 IOM 12-46 PETROL


Hugoton Pool

KANSAS

Section 11 Township 28 Range 36W

Well No. 1 Congdon

Company Columbian Fuel

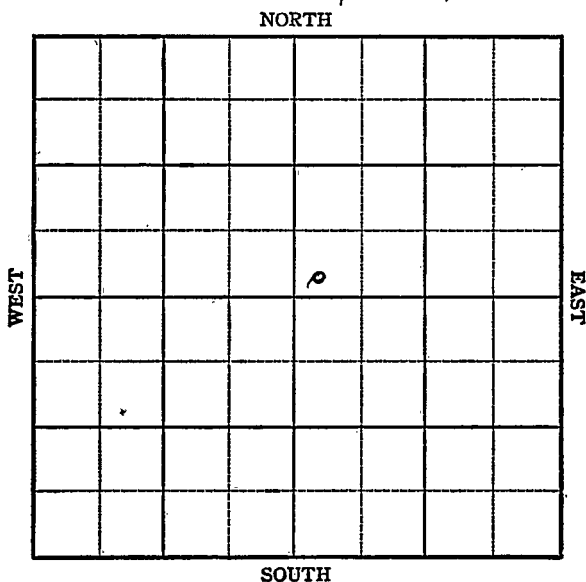

KANSAS

Grant

Sec. 11 Twp. 28 R. 36-W

Well No. #1 Congdon Farm


Columbian Fuel Company  
Hugoton Pool

         Ft. from N. Line

100 Ft. from S. Line

         Ft. from E. Line

100 Ft. from W. Line

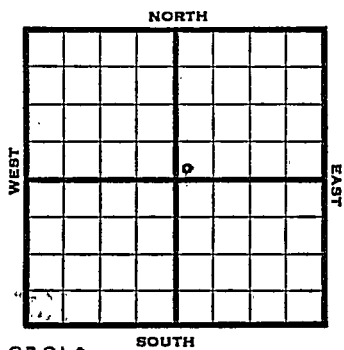

SW NE

Elev. 3104'

1947

REPORT

2/26 Location

3/4 10" @ 505'  
Drlg 2200'

3/11 TD 2542  
7" @ 2535'  
RUST

3/18 SD

3/25 Drlg 2710'

4/2 TD 2762  
248 of 5" Perf liner @ 2762

4/9 15000 acid.


4/16 TD 2762'  
7" @ 2535  
248' of 5" Perf Liner @ 2762  
15000 Acid  
18,736,000 Gas  
422# R Pr  
TD 2762'

COMPLETED

Map No. \_\_\_\_\_ Sec. 11 Twp. 28 R. 36WWell No. 1 CongdonColumbian Fuel CompanyFIRST REPORT Contractor

SW NE

## SECTION PLAT

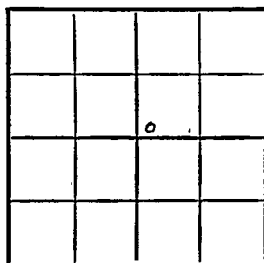

\_\_\_\_\_ Ft. from N. Line

100 Ft. from S. Line

\_\_\_\_\_ Ft. from E. Line

100 Ft. from W. Line

Grant County

Location X

Rig up \_\_\_\_\_

Drilling and Remarks:

## RECORD

Cased \_\_\_\_\_ in., \_\_\_\_\_ ft.

Sand \_\_\_\_\_

Gas \_\_\_\_\_

Oil \_\_\_\_\_

Total Depth \_\_\_\_\_

## PRODUCTION

1st 24 hrs. Nat. \_\_\_\_\_

1st 24 hrs. after shot \_\_\_\_\_

Gas \_\_\_\_\_ Cu. Ft.

Dry Hole \_\_\_\_\_

Abandoned \_\_\_\_\_

Date

FEB 26 1947

19

S. J. LEWIS Scout

Kansas

KANSAS

Hugoton Pool

Map No. \_\_\_\_\_ Sec. 11 Twp. 28 R. 36WWell No. 1 Congdon


Columbian Fuel

Company

COMPLETE

Contractor

SW NE

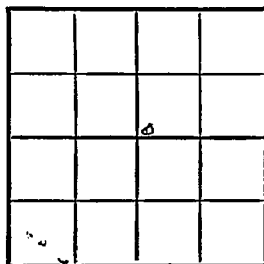E 13104  
SECTION PLAT

\_\_\_\_\_ Ft. from N. Line

100 Ft. from S. Line

\_\_\_\_\_ Ft. from E. Line

100 Ft. from W. Line

Grant County

Location \_\_\_\_\_

Rig up \_\_\_\_\_

Drilling and Remarks:

77527627102535245' of 5" Perflines @ 276215000 acf15,736,000 Gas422 4 R 1/2

## RECORD

Cased \_\_\_\_\_ in., \_\_\_\_\_ ft.

Sand \_\_\_\_\_

Gas \_\_\_\_\_

Oil \_\_\_\_\_

Total Depth 2762

## PRODUCTION

1st 24 hrs. Nat. \_\_\_\_\_

1st 24 hrs. after shot \_\_\_\_\_

Gas \_\_\_\_\_ Cu. Ft.

Dry Hole \_\_\_\_\_

Abandoned \_\_\_\_\_

Date

APR 16 1947

19

S. J. LEWIS

Scout